




CLAIM OF BENEFICIAL USE MAP FOR TRANSFER T-11170,
 PERMIT 37121, CERTIFICATES 86127 AND 86214 AND
 PERMIT 37833, CERTIFICATE 80911
 IN THE NAME OF STANFIELD HUTTERIAN FARM C/O HERB STHAL
 T4N, R30E, W.M., UMATILLA COUNTY

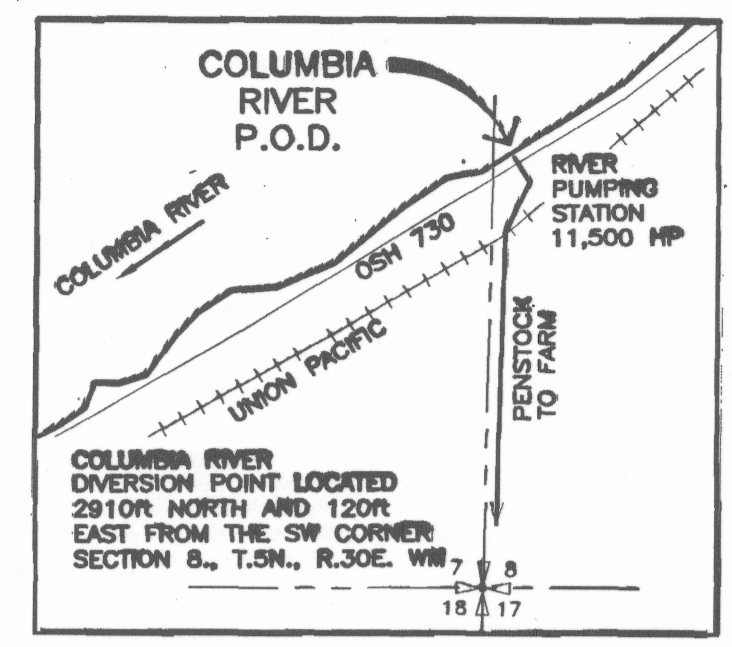

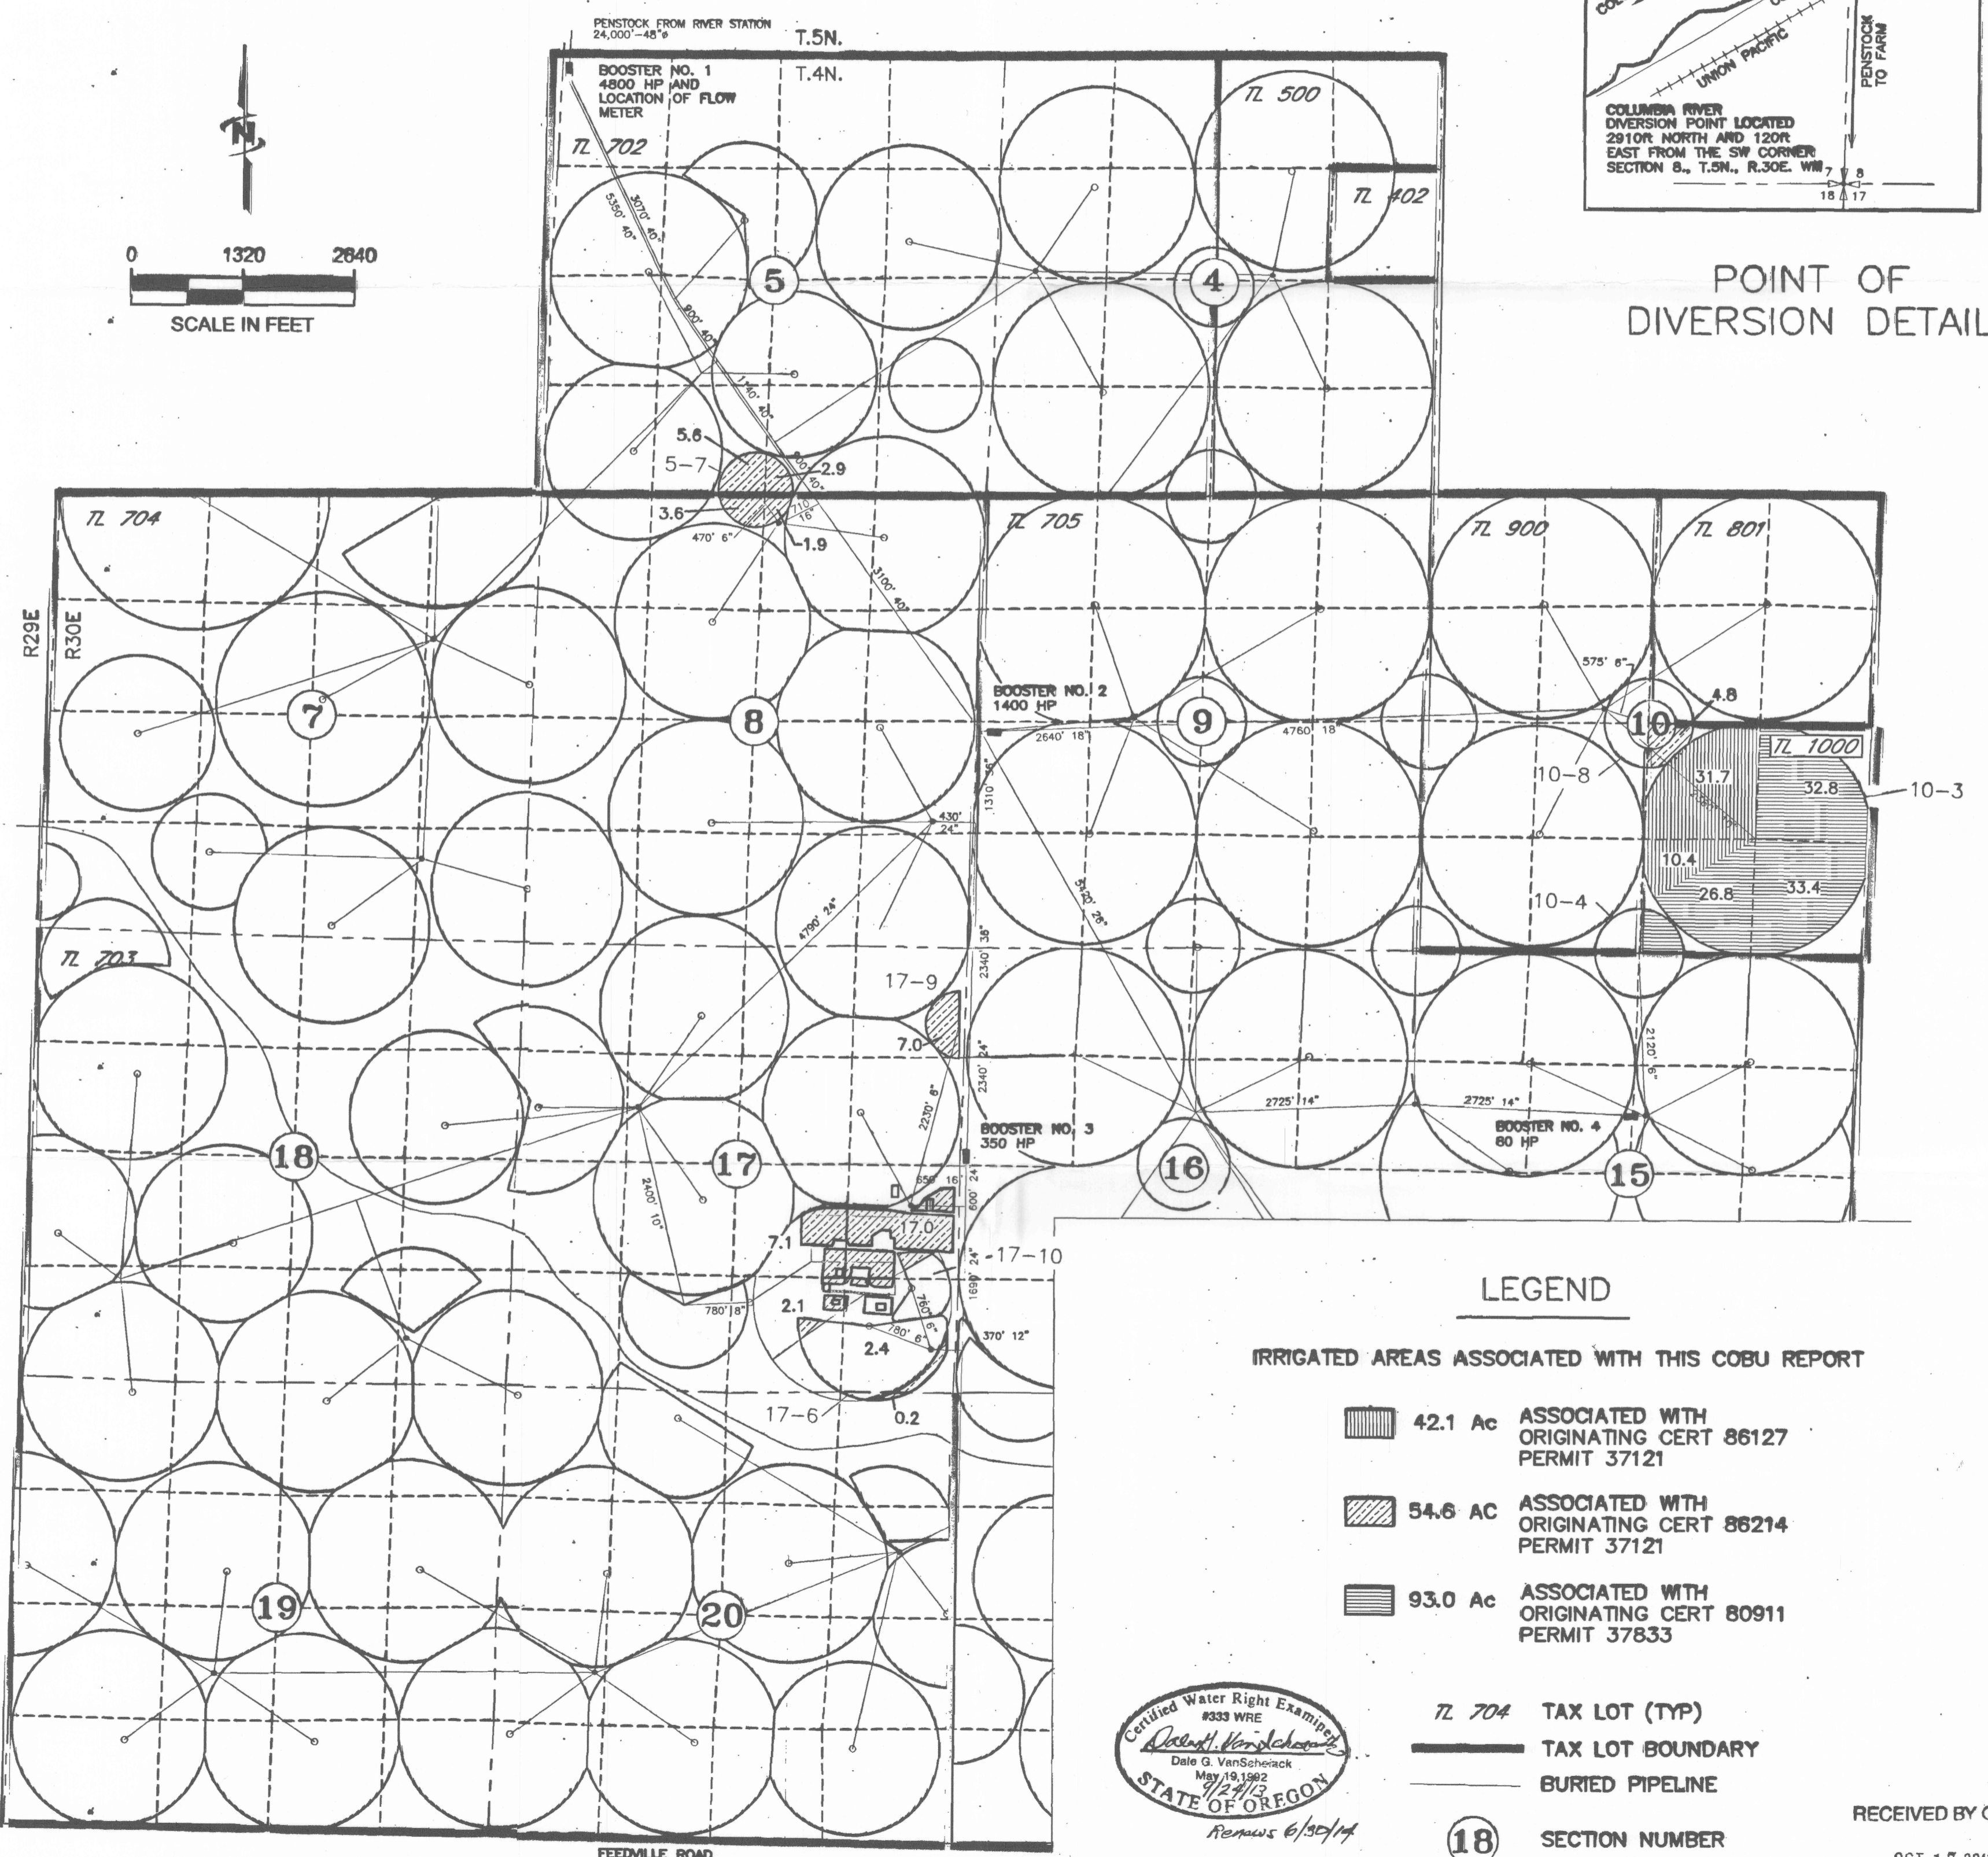

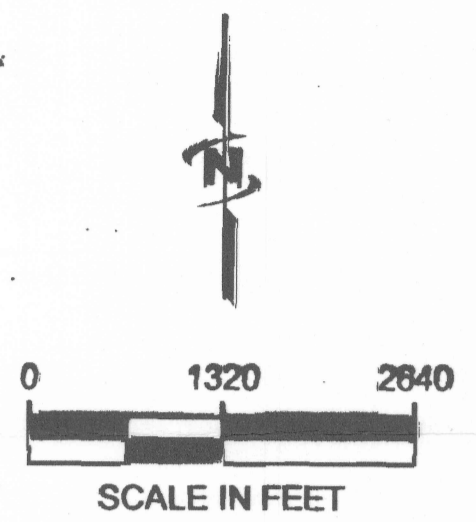


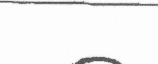

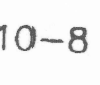
POINT OF DIVERSION DETAIL




LEGEND

IRRIGATED AREAS ASSOCIATED WITH THIS COBU REPORT

-  42.1 Ac ASSOCIATED WITH ORIGINATING CERT 86127 PERMIT 37121
-  54.6 AC ASSOCIATED WITH ORIGINATING CERT 86214 PERMIT 37121
-  93.0 Ac ASSOCIATED WITH ORIGINATING CERT 80911 PERMIT 37833

-  TL 704 TAX LOT (TYP)
-  TAX LOT BOUNDARY
-  BURIED PIPELINE
-  SECTION NUMBER
-  CIRCLE NUMBER

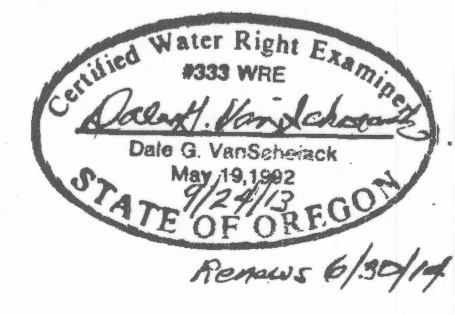

RECEIVED BY OWRD

OCT 17 2013


SALEM, OR

NOTE:
 THE PURPOSE OF THIS MAP IS TO IDENTIFY THE APPROXIMATE LOCATION OF THE WATER RIGHT. IT IS NOT INTENDED TO PROVIDE INFORMATION RELATIVE TO THE LOCATION OF PROPERTY OWNERSHIP BOUNDARY LINES. THE CIRCLE LAYOUT AND PIPE DISTRIBUTION SYSTEM ARE BASED ON FARM MAPS, FIELD OBSERVATIONS AND DESCRIPTIONS PROVIDED BY THE OWNER.



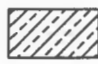
COBU MAP # 792

TRANSFER APPLICATION MAP(S) FOR CERTs 87773, 87795, & A PORTION OF CERT 91692 IN THE NAME OF STANFIELD HUTTERIAN FARM AND A PORTION OF CERT 87111 IN THE NAME OF HALE FARMS, LLC
T3N, & T4N, R30E, W.M., UMATILLA COUNTY
SHEET 5 OF 9


FROM MAP for a portion of Cert 91692 &
TO MAP for a portion of Cert 91692

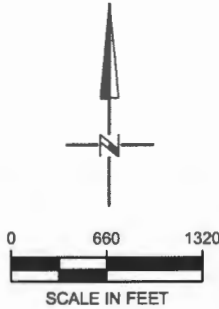


LEGEND

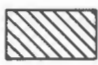-  FROM ACRES ASSOCIATED WITH CERT 91692 (4.2 ACRES)
-  TO ACRES ASSOCIATED WITH CERT 91692 (4.2 ACRES)
-  PORTION OF CERT 91692 IN QTR QTR NOT INVOLVED IN THIS TRANSFER (17.5 ACRES)

NOTE: FOR LOCATION OF POINT OF DIVERSION REFER TO SHEET 1

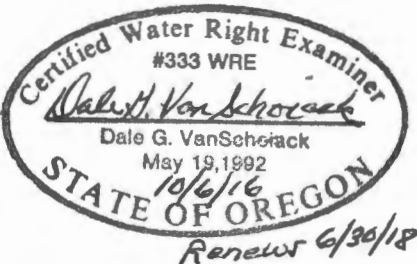

NOTE: THE PURPOSE OF THIS MAP IS TO IDENTIFY THE APPROXIMATE LOCATION OF THE WATER RIGHT. IT IS NOT INTENDED TO PROVIDE INFORMATION RELATIVE TO THE LOCATION OF PROPERTY OWNERSHIP BOUNDARY LINES.

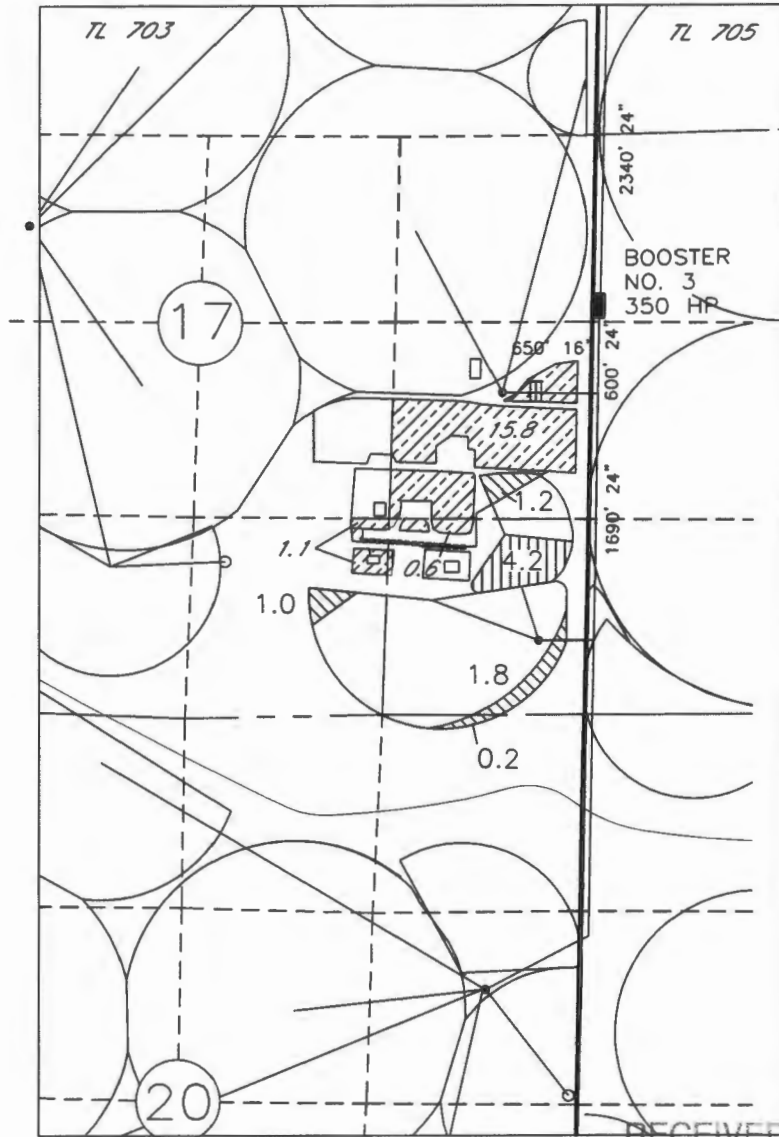

T4N, R30E, W.M.

RECEIVED BY OWRD

OCT 31 2016

SALEM, OR

DGV Consulting, PLLC
PHONE (509) 627-8717
dalevconsulting@gmail.com
Date: Oct 5, 2016

T 12516