


# WATER RIGHT CLAIM OF BENEFICIAL USE MAP

T-13483

FLOWERS OF THE SUN LLC  
234 BROWNS ROAD  
WILLIAMS, OR 97544

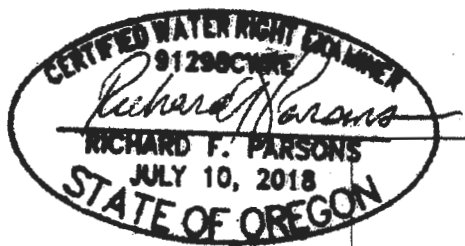




SITUATED IN SECTION 35 T38S R5W, W.M.  
JOSEPHINE COUNTY OREGON

## LEGEND

- FLOWERS PUMP – POINT OF DIVERSION and FISH SCREEN  
850' NORTH AND 450' EAST OF  
SOUTHWEST CORNER OF SECTION 35
- FLOWERS PUMP METER  
~215' SOUTHEAST OF FLOWERS PUMP  
665' NORTH AND 555' EAST OF  
SOUTHWEST CORNER OF SECTION 35

T-13483 PLACE OF USE IN SW SW SECTION 35

-  C-16317 – 0.8 ACRES
-  C-3353 – 12.62 ACRES

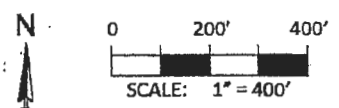

*This map is not intended to provide legal dimensions or locations of property ownership lines*

