


ORMO
RECEIVED
SEP 1 1 2019
RECEIVED

RECEIVED
SEP 1 1 2019
OWRD

Claim of Beneficial Use Groundwater Transfer T-11782

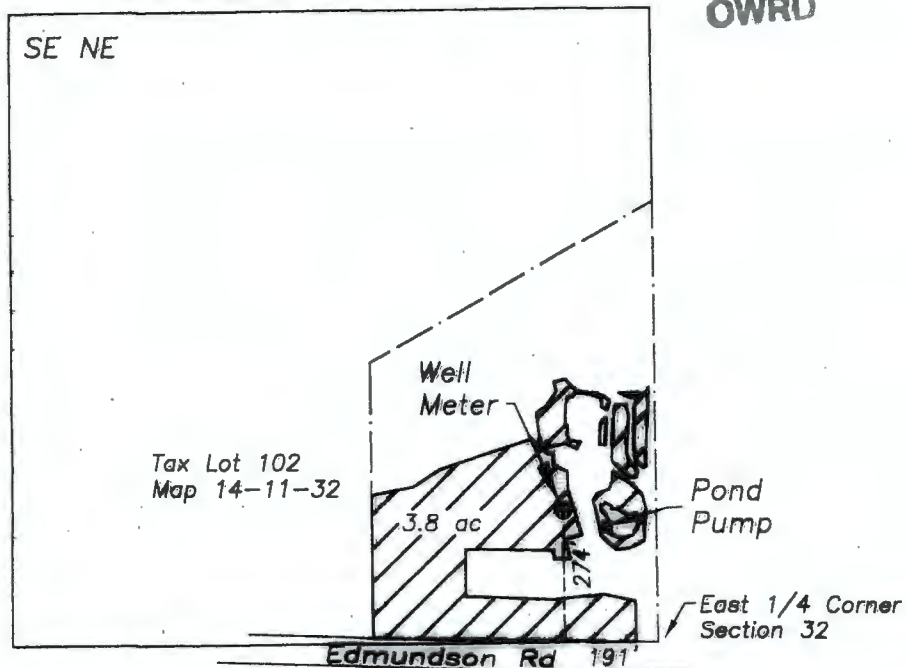

Section 32
T14S, R11E, W.M.
Deschutes Co., Oregon



Renewal date: 6/30/2020

Legend



Water beneficially used under T-11782
(priority date 3/4/1980)



Property line



Well (Point of Appropriation)



GRAPHIC SCALE - FEET

THIS MAP IS FOR THE PURPOSE OF IDENTIFYING THE LOCATION OF THE WATER RIGHT. IT IS NOT INTENDED TO PROVIDE LEGAL DIMENSIONS OR LOCATIONS OF PROPERTY OWNERSHIP LINES.

Point of Appropriation

274' North and 191' West from East 1/4 Corner
of Section 32