


EXHIBIT B

T31S, R37E, W.M.  
Harney County, Oregon

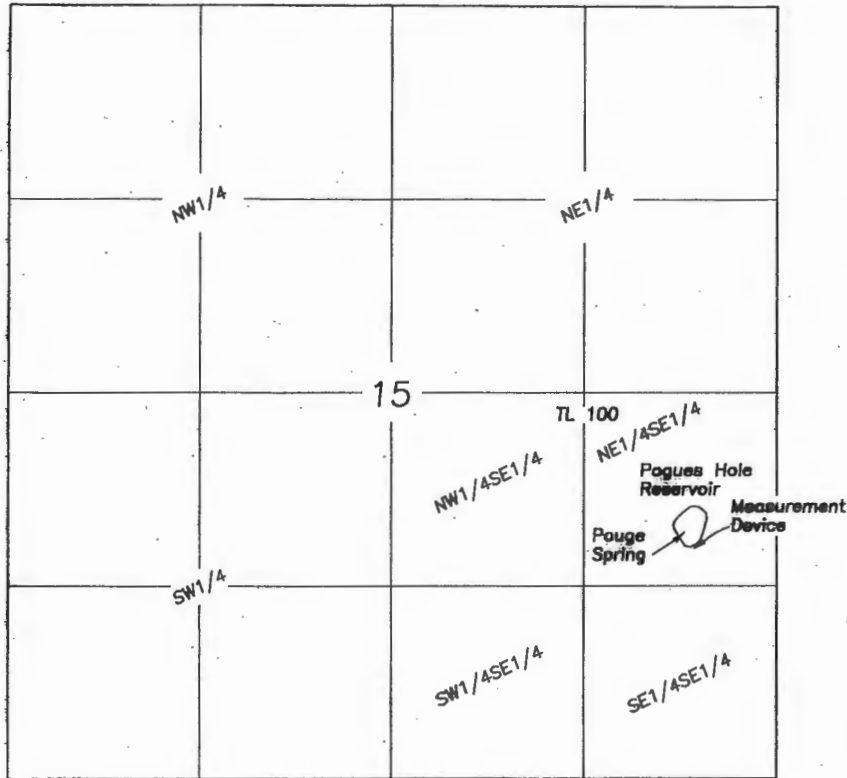

SCALE 1"=1320'

Outlet is located S9°W, 3740' from the  
NE corner of Section 15.

Measuring device is located 14' South  
of the Outlet.

FINAL PROOF SURVEY  
CLAIM OF BENEFICIAL USE  
POGUES HOLE RESERVOIR

For

Bureau of Land Management

May 19, 2022

Prepared by

Cornerstone Surveying, Inc

P.O. BOX 33

JOHN DAY, OR. 97845

(541)575-1813

jwsurvey55@gmail.com

LEGEND

Application No. R-68900

Permit No. R-11904

Priority 9/24/1986

A portion of Tax Lot  
31-37 TL100

NOTE: Tax Lot 100 is owned by the BLM  
and is more than 21,300 acres.

NOTE: The preparation of this map  
was for the purpose of identifying  
the location of the proposed water  
right and has no intent to provide  
dimensions or location of property  
ownership lines.

