


T 30 S, R 45 E, WM

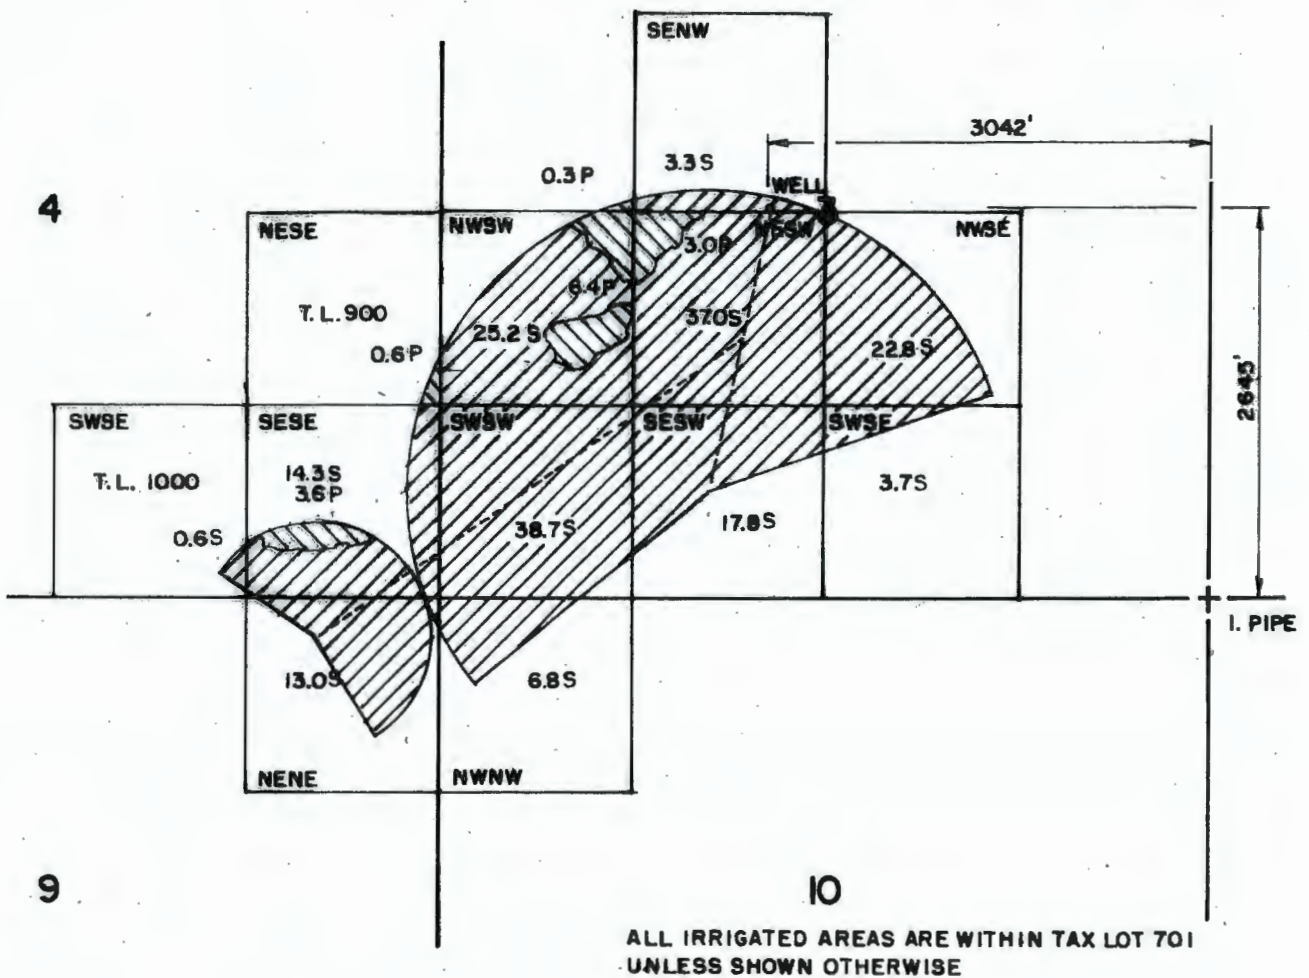

RECEIVED

AUG 11 2008

WATER RESOURCES DEPT.
SALEM, OREGON

**PRIMARY
SECONDARY**

RECEIVED

JAN 02 2001

WATER RESOURCES DEPT
SALEM, OREGON

THE PURPOSE OF THIS MAP IS TO IDENTIFY THE LOCATION OF THE WATER RIGHT. IT IS NOT INTENDED TO PROVIDE INFORMATION RELATIVE TO THE LOCATION OF PROPERTY OWNERSHIP.

REVISÉ 12-13-2000

FINAL PROOF SURVEY

UNDER
APPLICATION NO. G-13420
PERMIT NO. G-12558

**IN THE NAME OF
RABURN RANCHES**

Scale: 4" = 1 MILE

Date: **JULY 2000**

Job: 1951

Dsn:

Dm: CHRIS

' Ckd:

MAP's

M.A. PALMER & SONS, INC.
ENGINEERING & SURVEYING
711 Ponderosa Village • Box 61
Burns, Oregon 97720

Sht. No.

of 1



RENEW 1-1-2001