

SALEM OREGON

RECEIVED
OCT 1 2010

WATER RESOURCES DEPT

OCT 12 2010

RECEIVED


SCALE: 1"=1320'

LEGEND

-  Lands with primary water rights
-  Building
-  Gravel Driveway
-  Mainline



NOTE: The preparation of this map was for the purpose of identifying the location of the water rights and has no intent to provide dimensions or location of property ownership lines. Location information shown hereon was furnished by the applicant.

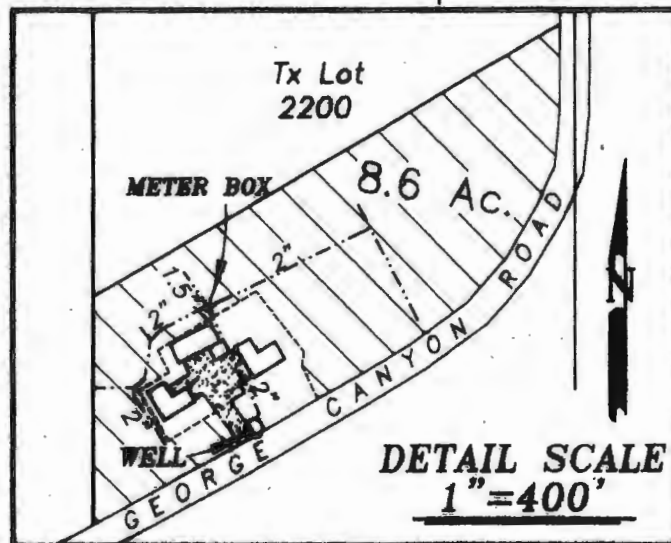

September 7, 2010

FINAL PROOF MAP FOR WATER RIGHTS FROM WELL FOR

RICHARD AND DEANNA THOMAS
BY

BAGETT - GRIFFITH & BLACKMAN
2006 ADAMS AVENUE
LAGRANDE, OREGON 97850

Application No. G-16549

Permit Number G-16064