


T27S, R32E, W.M.
Harney County, Oregon

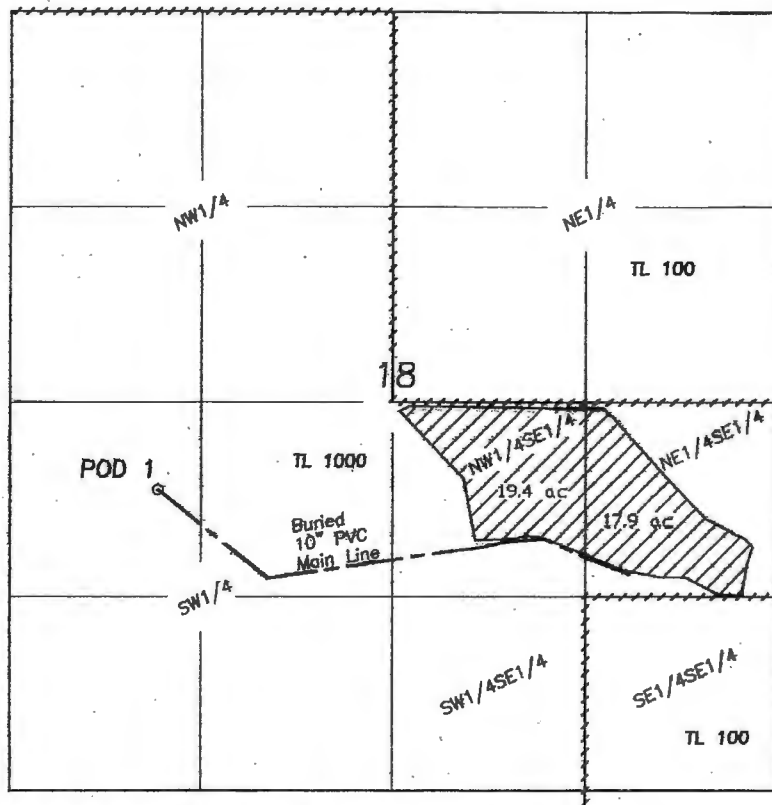

POB 1 is located 600' South & 4270' West of the
E1/4 corner of Section 18.



SCALE 1"=1320'

RECEIVED BY OWRD

APR 05 2017

SALEM, OR

FINAL PROOF SURVEY
CLAIM OF BENEFICIAL USE

For

Tom R. Davis & Julie A. Davis
March 13, 2017

LEGEND

Application No. G-17525
Permit No. G-16961
Priority 1/23/2012

----- Tax Lot Boundary

A portion of Tax Lot
27-32 TL1000

NOTE: The preparation of this map
was for the purpose of identifying
the location of the proposed water
right and has no intent to provide
dimensions or location of property
ownership lines.

Prepared by
Cornerstone Surveying, Inc
P.O. BOX 33
JOHN DAY, OR. 97845
(541)575-1813
cornerstonesurvey@centurytel.net

