


Permit # 9170
9724

Sec. 11, T. no. 10 S., Range no. 30 E. Wm. Grant Co.
Oregon

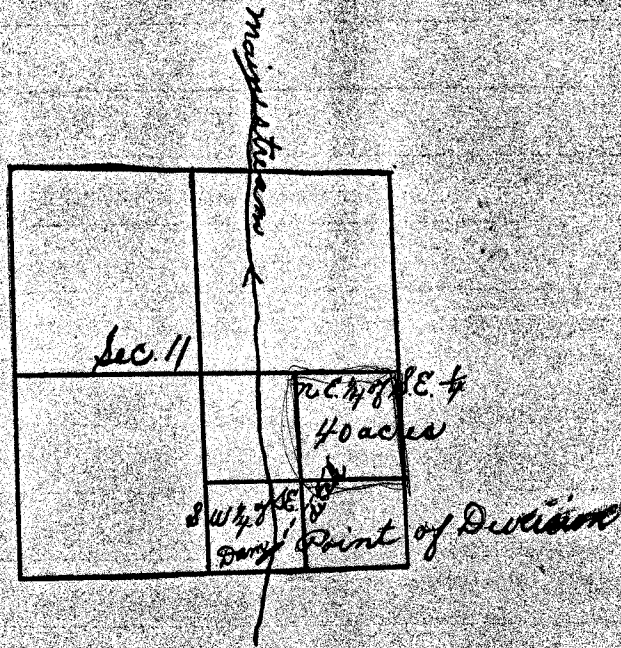

Application No. 12869
Permit No. 9170