



Claim of Beneficial Use Map
A G-17548, T-12076, P G-17528
Justin & Jayna Ferrell

T 35 S, R 21 E, WM
 Section 32

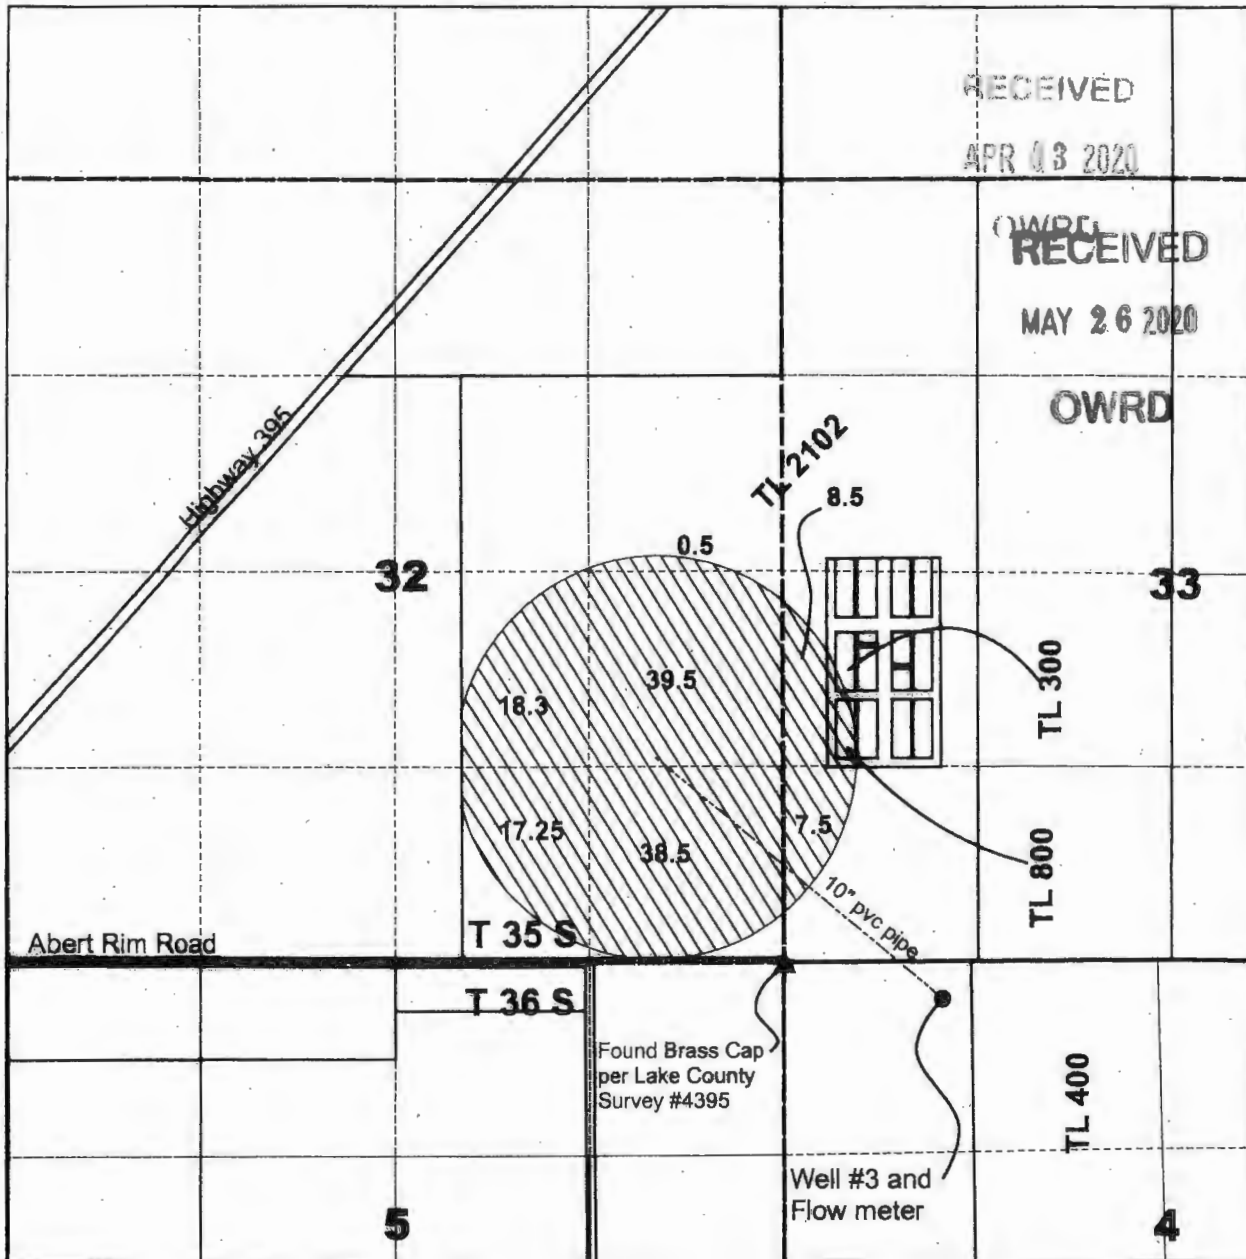

Well #3 is located 230 feet South and 1053 feet East to the NW Corner, Sec. 4, T36S, R21E, WM.

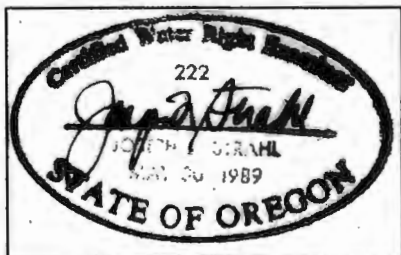

Legend

- Area irrigated 130.05 ac
- Pipeline
- POA Well #3
- Section Cor. found

N

 1 inch = 1,320 feet

Note: This map is not intended to provide legal dimensions or locations of property ownership lines.