Claim of Beneficial Use

Permit R-15312, Application R-86762

A Water Right held by Roserock West 2 LLC
Polk County

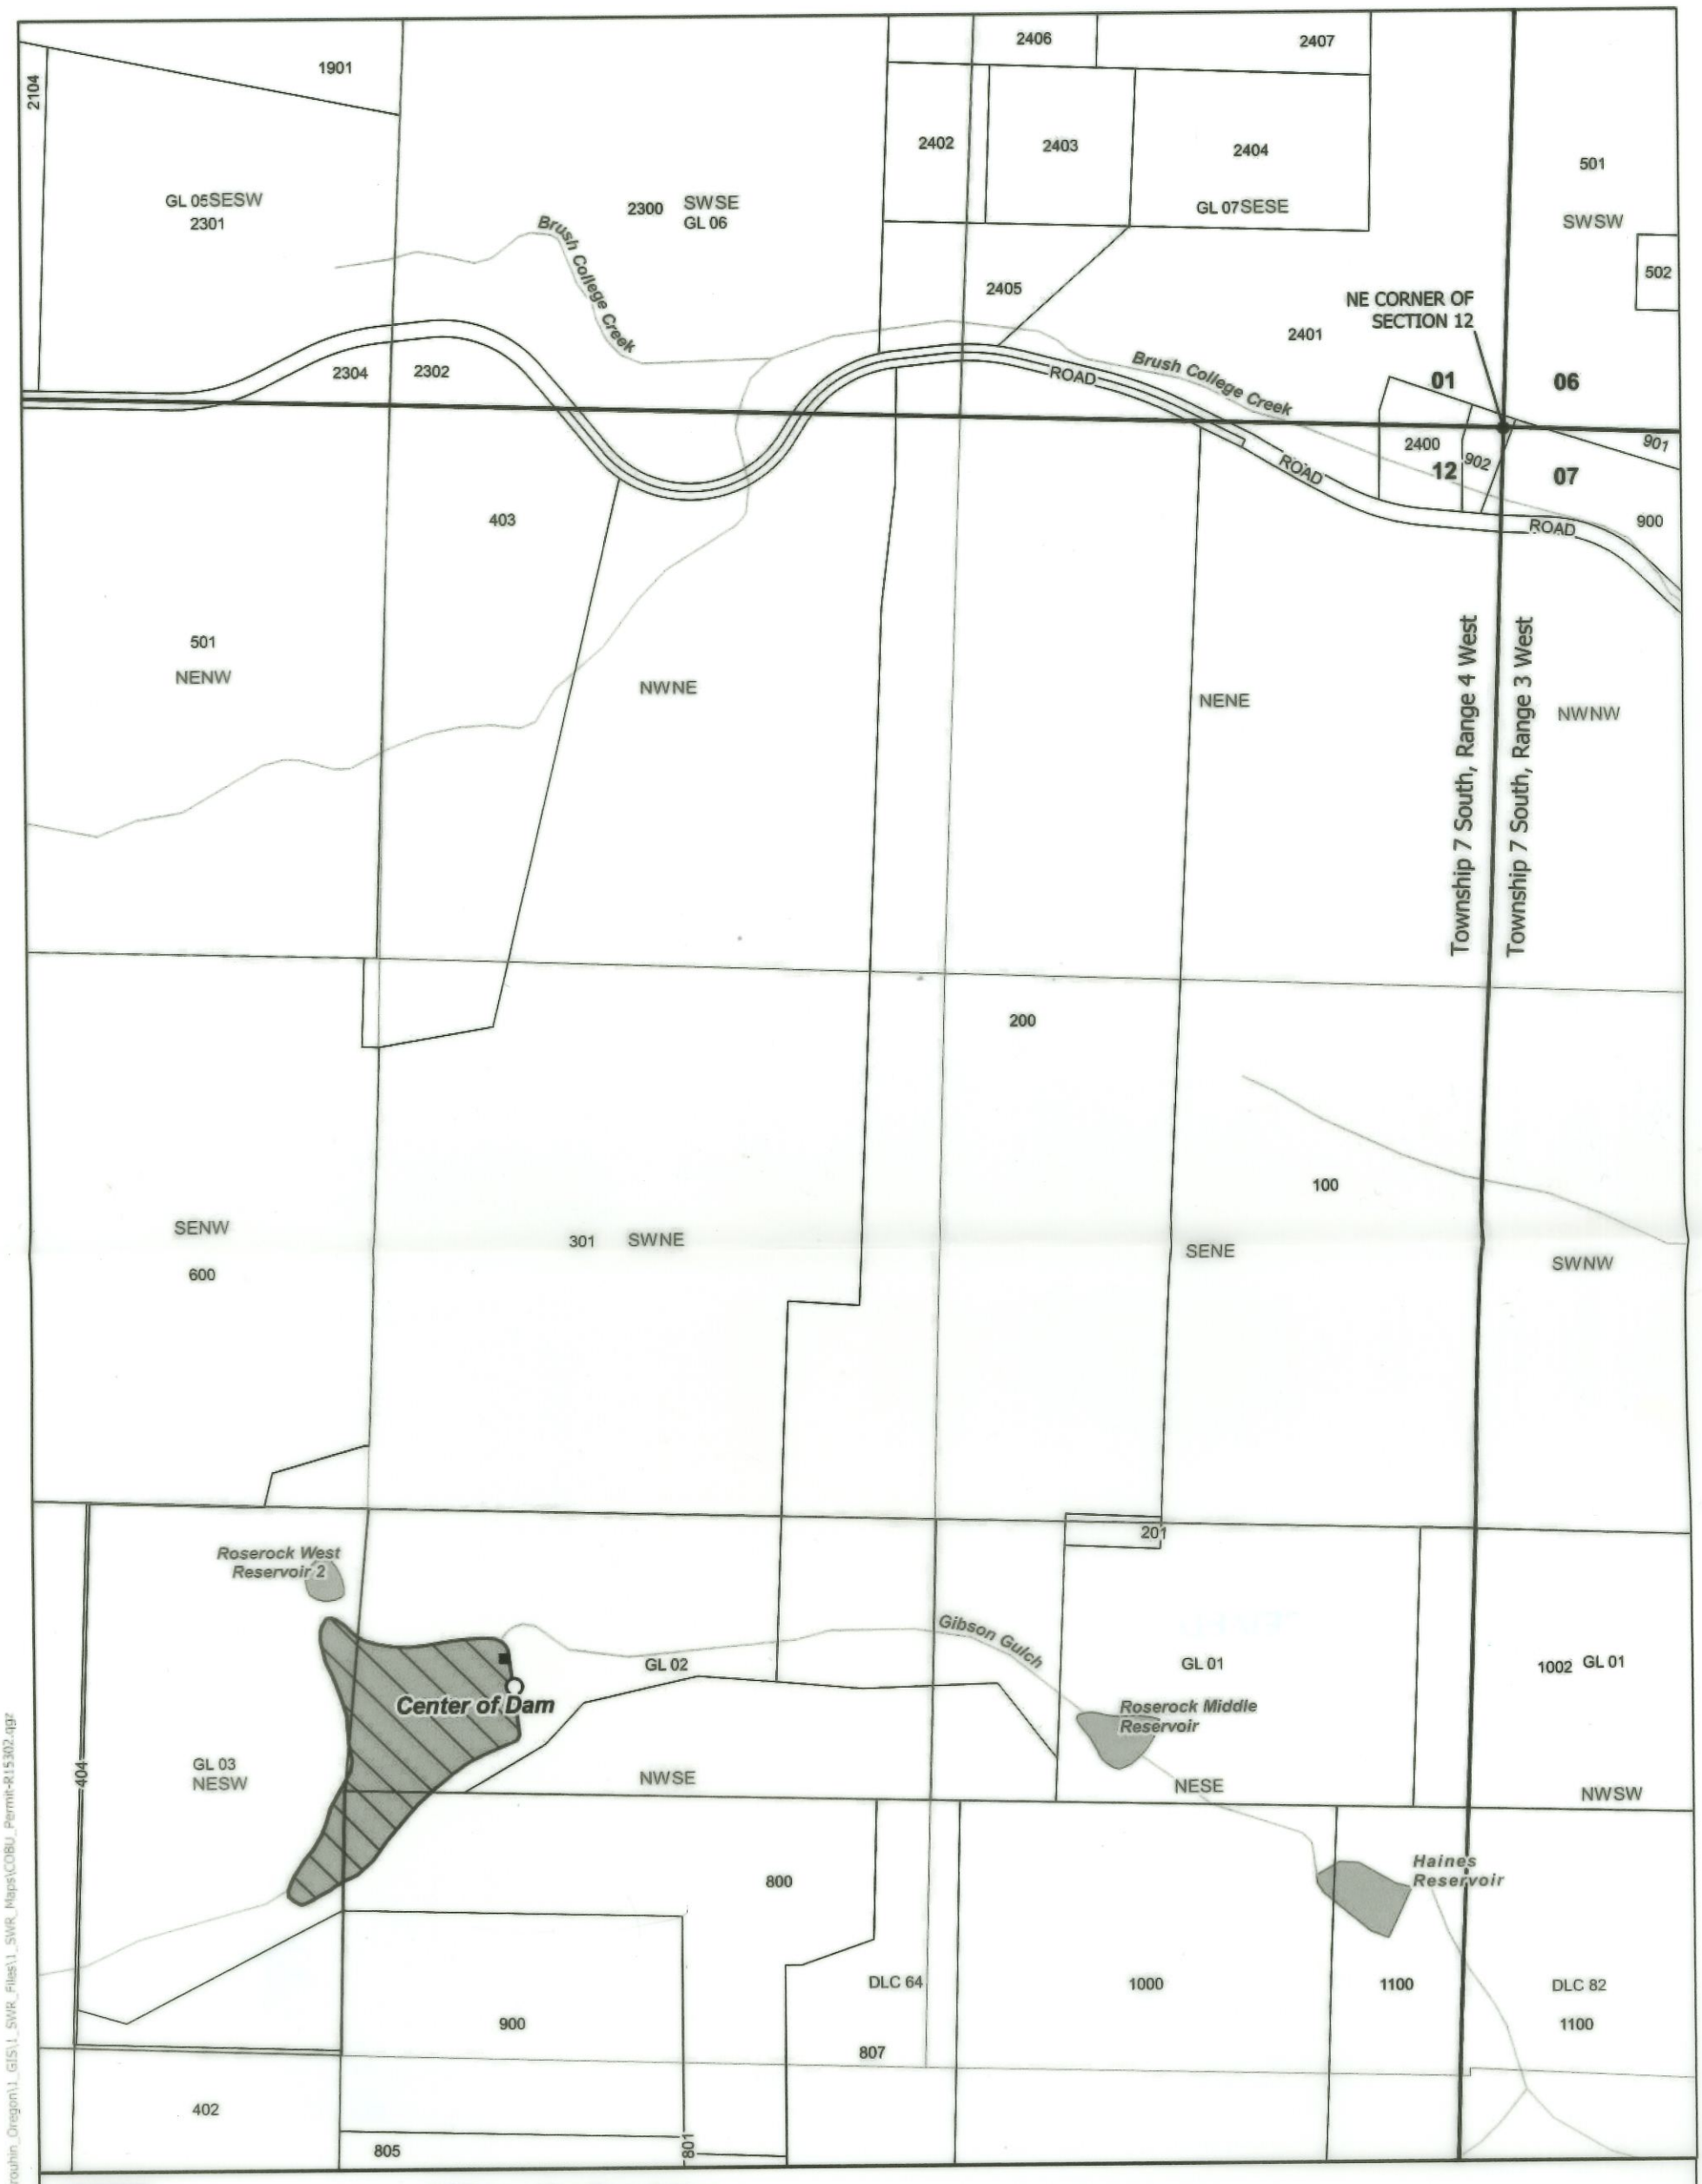

LEGEND

- Point of Appropriation (POD)
- Staff Gage
- Place of Use (POU)
- Donation Land Claim (DLC)
- Government Lot (GL)
- Property Lines
- Streams

N

Scale
0 200 400 ft
1-inch = 400 feet

POD Location Description

Center of Dam
Located 3072 feet South and 2370 feet Wast from the NE corner of Section, Township 7 South, Range 4 West, W.M.

CERTIFIED WATER RIGHTS EXAMINER
#78185CWRE
THEODORE R. RESSLER
JUNE 29, 2007
STATE OF OREGON

RENEWS: 12·31·2024

CWRE Seal and Signature

RECEIVED
JAN 26 2023
OWRD

Date: 12/5/2022
Data Sources: BLM, OWRD, Polk County
Disclaimer: This map is not intended to provide legal dimensions or property ownership lines.

summit WATER RESOURCES

C:\OneDrive\Geo-Logic Associates Inc\SWR - Files\Project\Domaine_Drouhin_Oregon\1_GIS\1_SWR_Files\1_SWR_Maps\COBU_Permit-R15302.qgz