


- Fish Exclusion Valve
- Reservoir Dam at Outlet & Staff Gauge

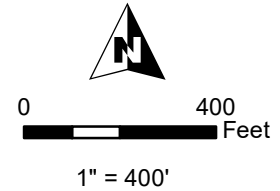


**T16S R5W, WM
LANE COUNTY, OR**



- Creek
- DLC Line
- Section
- Quarter Quarter
- Tax Lot
- ▨ Reservoir - Storage

RENEWAL DATE 12/31/2024

Dam at Outlet Location:
 #1: 490' S, 810' E of NW Cor Sec 17
 #2: 820' S, 960' E of NW Cor Sec 17
 #3: 1210' S, 1530' E of NW Cor Sec 17
 #4: 280' S, 1390' E of NW Cor Sec 17
 #5: 350' S, 1580' E of NW Cor Sec 17
 #6: 470' S, 1840' E of NW Cor Sec 17

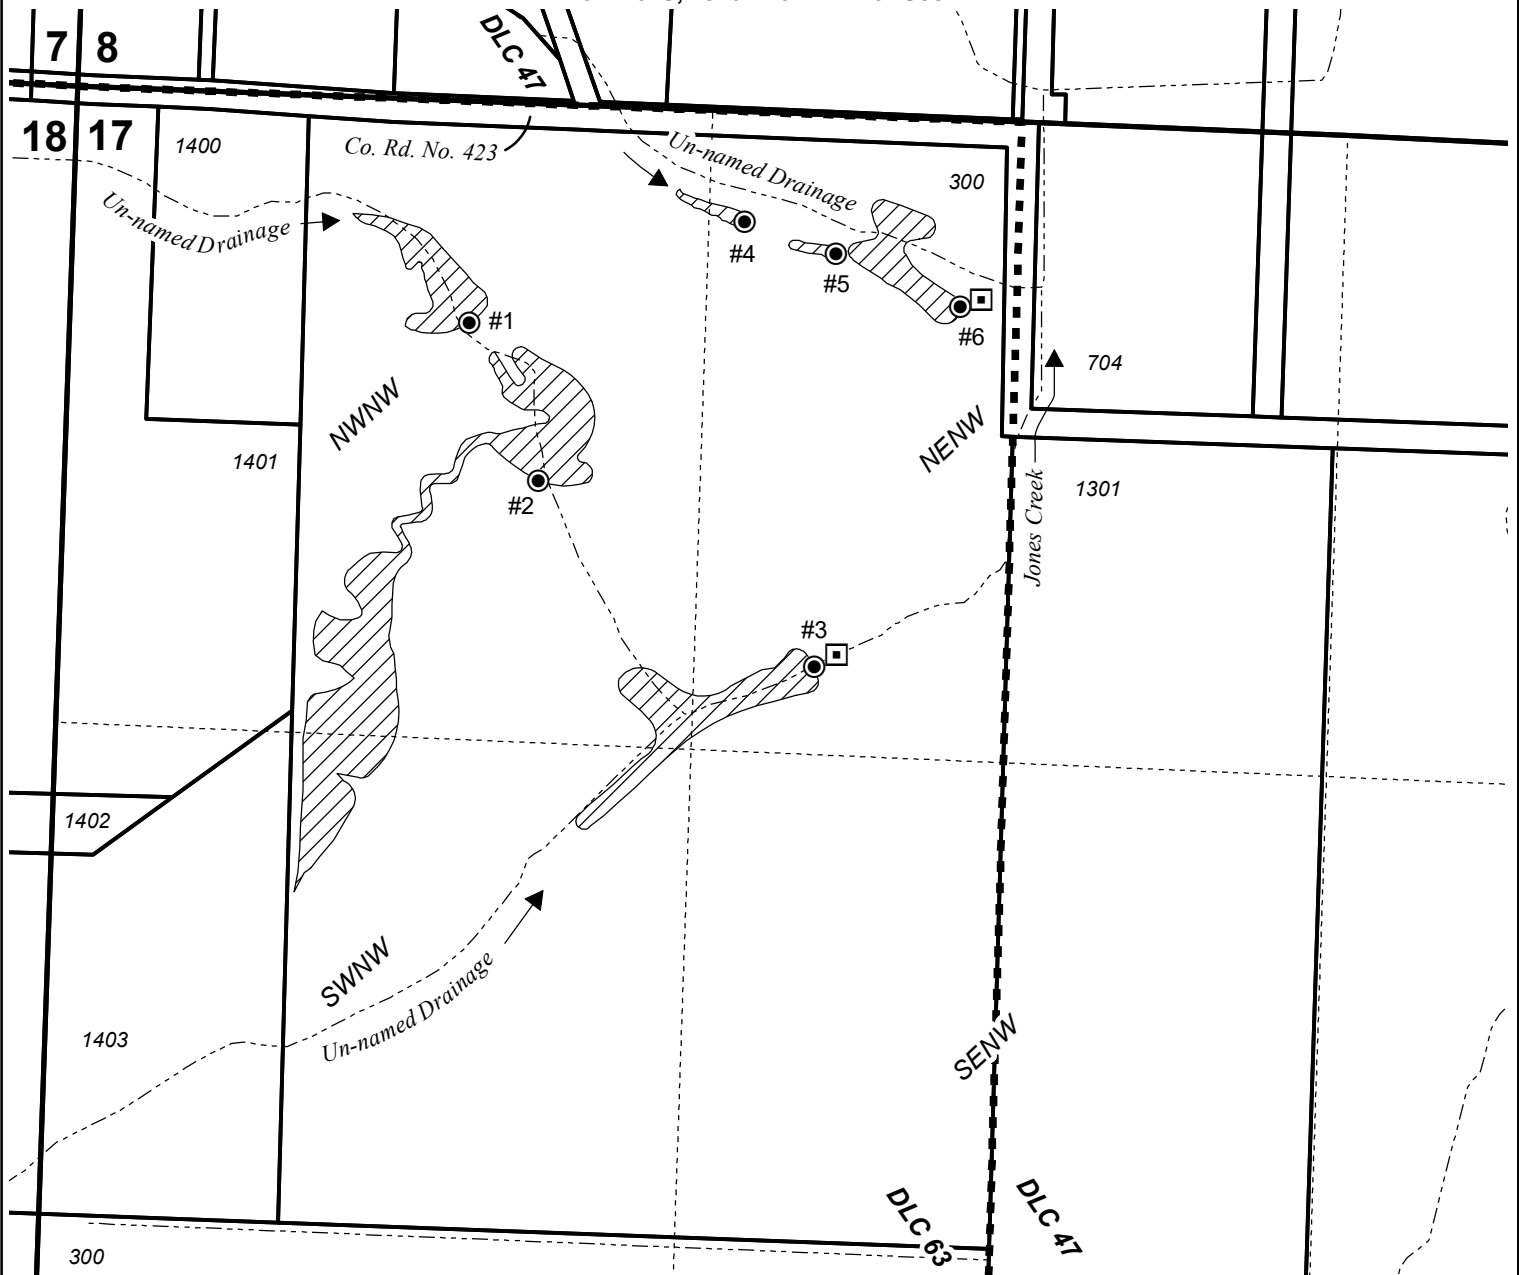

**CLAIM OF BENEFICIAL USE MAP
Vollstedt**

Project #22050
Date: 6/13/2023

Ap R-88182 Permit R-15283

This map is not intended
to provide legal dimensions
or locations of property
ownership lines.

WATER RIGHT SERVICES, LLC
 PO BOX 1830, BEND, OR 97709
WWW.OREGONWATER.US CCB # 197121
 johnshort@usa.com 541-389-2837