

SECTION 19 & 20 T3S, R4E W.M., CLACKAMAS COUNTY, OREGON

TAX LOT 400

RECEIVED


JAN 21 2023

OWRD

Transfer Number T-12160
Revision Date: April 20, 2023

Disclaimer - This map is not intended to provide legal dimensions or locations of property ownership lines.

COBU MAP #2045A

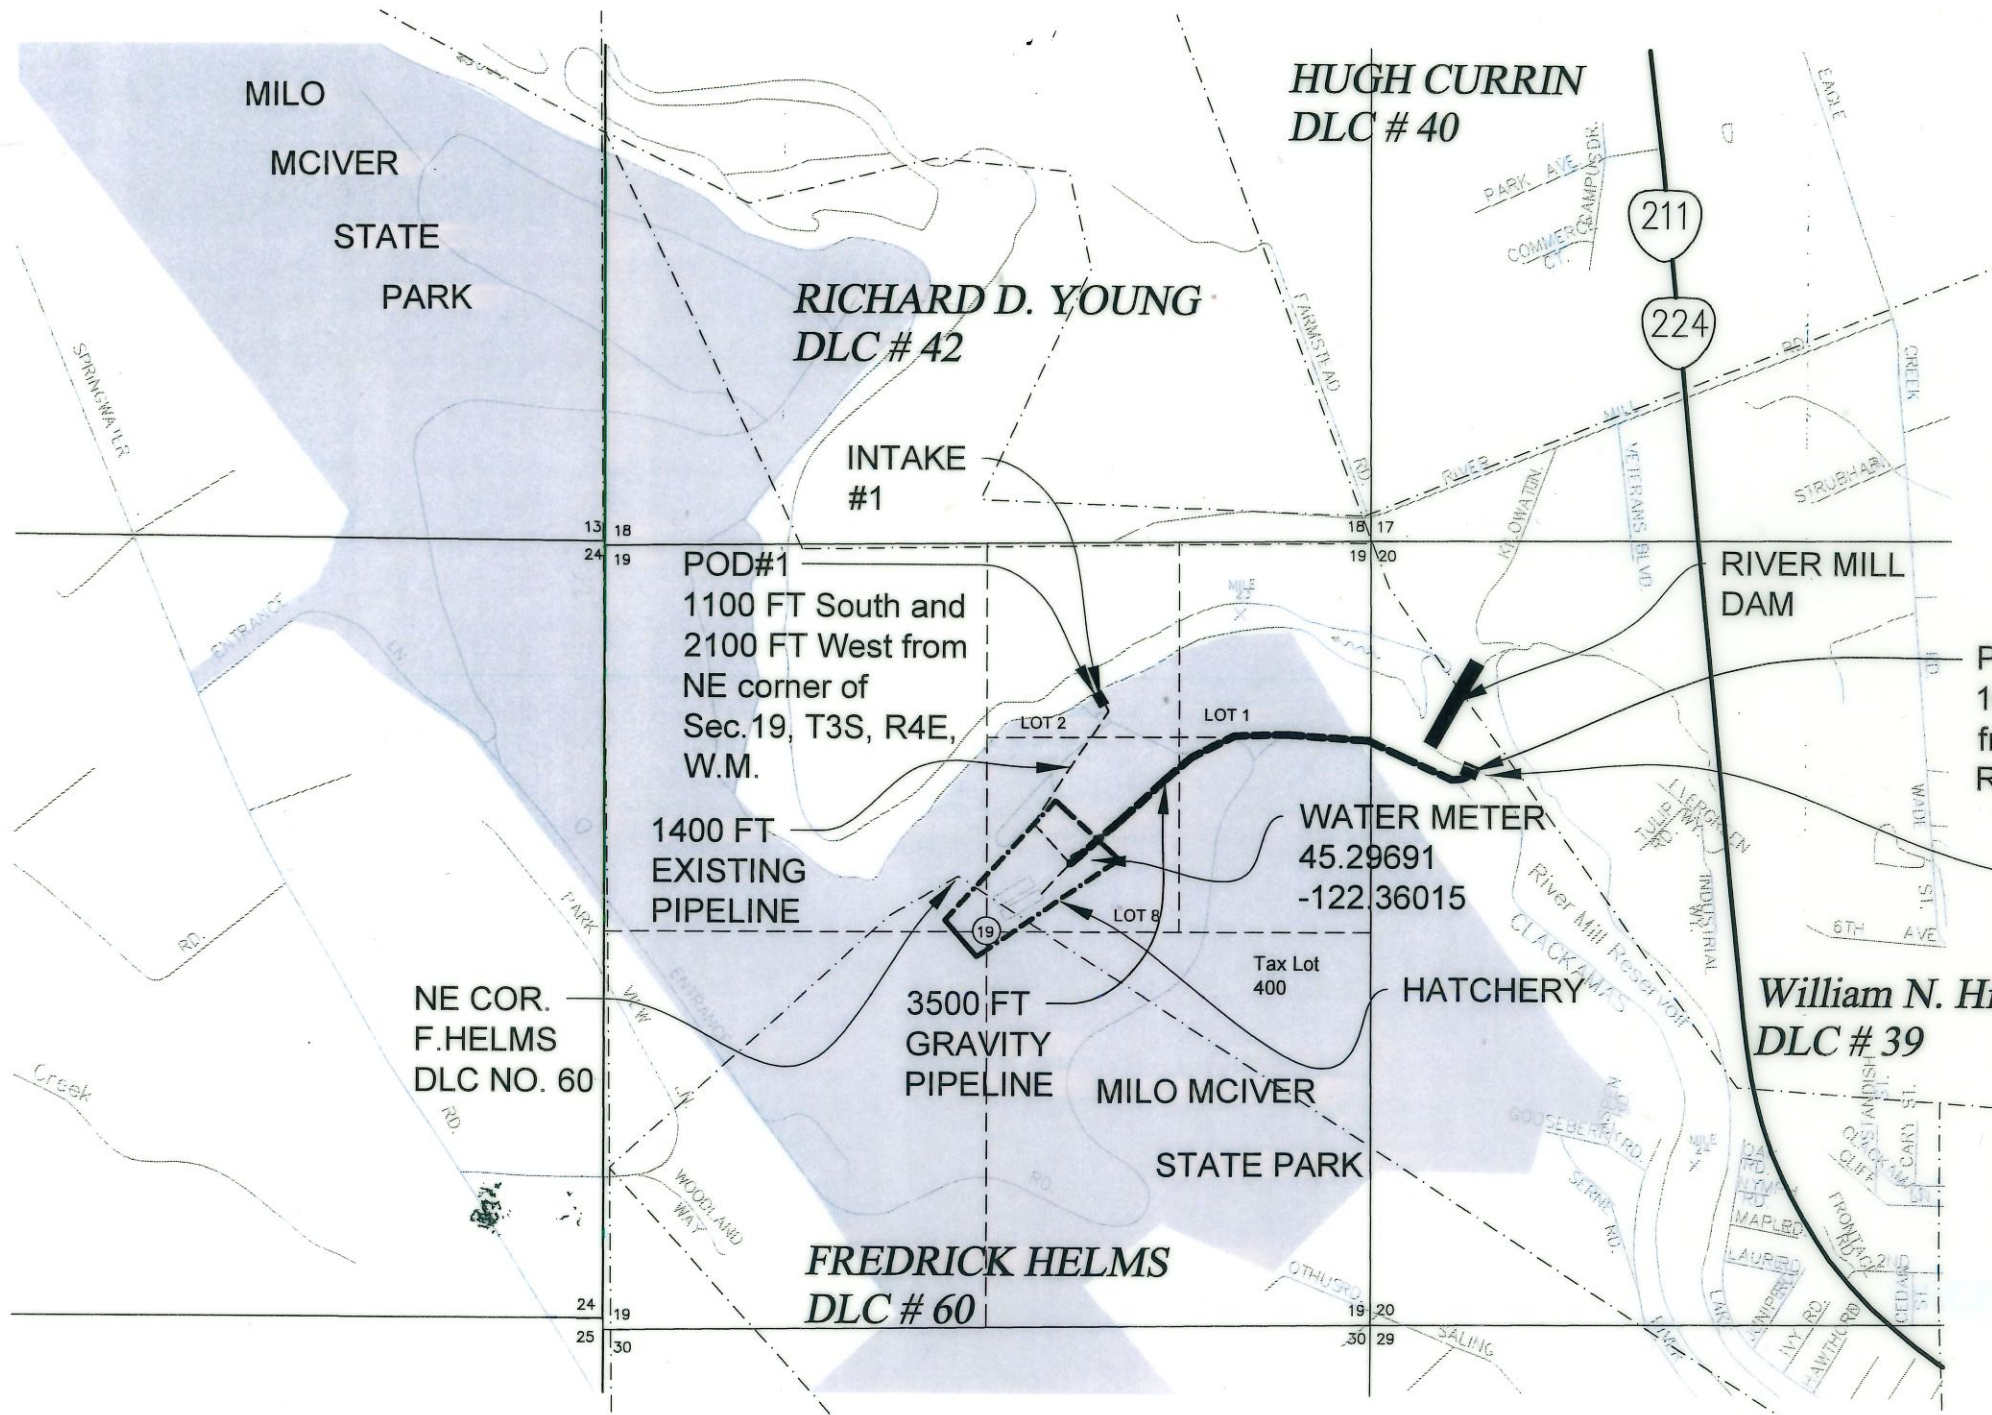


COBU MAP #2045A



SCALE: 1" = 1320'
0' 660' 1320' 2640'

CLAIM OF BENEFICIAL USE MAP

SCALE: 1" = 1320'

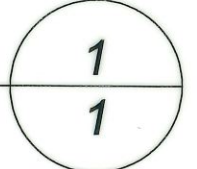

OREGON DEPARTMENT OF FISH AND WILDLIFE

