

Claim of Beneficial Use Map


Application G-14681, Permit G-13493
Water Right in the Name of Thomas Waliser
Township 5 North, Range 35 East (W.M.)



File Path: P:\Portland\499--Tom Waliser\001-Waliser COBU\Project_GIS\Project_mxd\COBU_G14993.mxd, Date: October 18, 2013 1:32:25 PM

- LEGEND**
- Point of Diversion (POD)
 - Primary Place of Use
 - Supplemental Place of Use
 - Mainline
 - Tax Lot
 - Government Lot
 - Watercourse
 - Waterbody

POD Location Description
Point of Diversion
Located 352.5 feet South and 1,330 feet East from the NW corner of Section 2, Township 5 North, Range 35 East (W.M.)

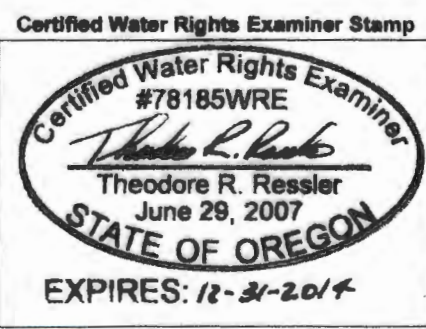

Disclaimer
This map was prepared for the purpose of identifying the location of a water right only and it is not intended to provide legal dimensions or location of property ownership lines.

RECEIVED BY OWRD **Map Notes**
Date: October 28, 2013
Data Sources: BLM, ESRI, USGS
Prepared By: GSI Water Solutions, Inc.

NOV 08 2013

