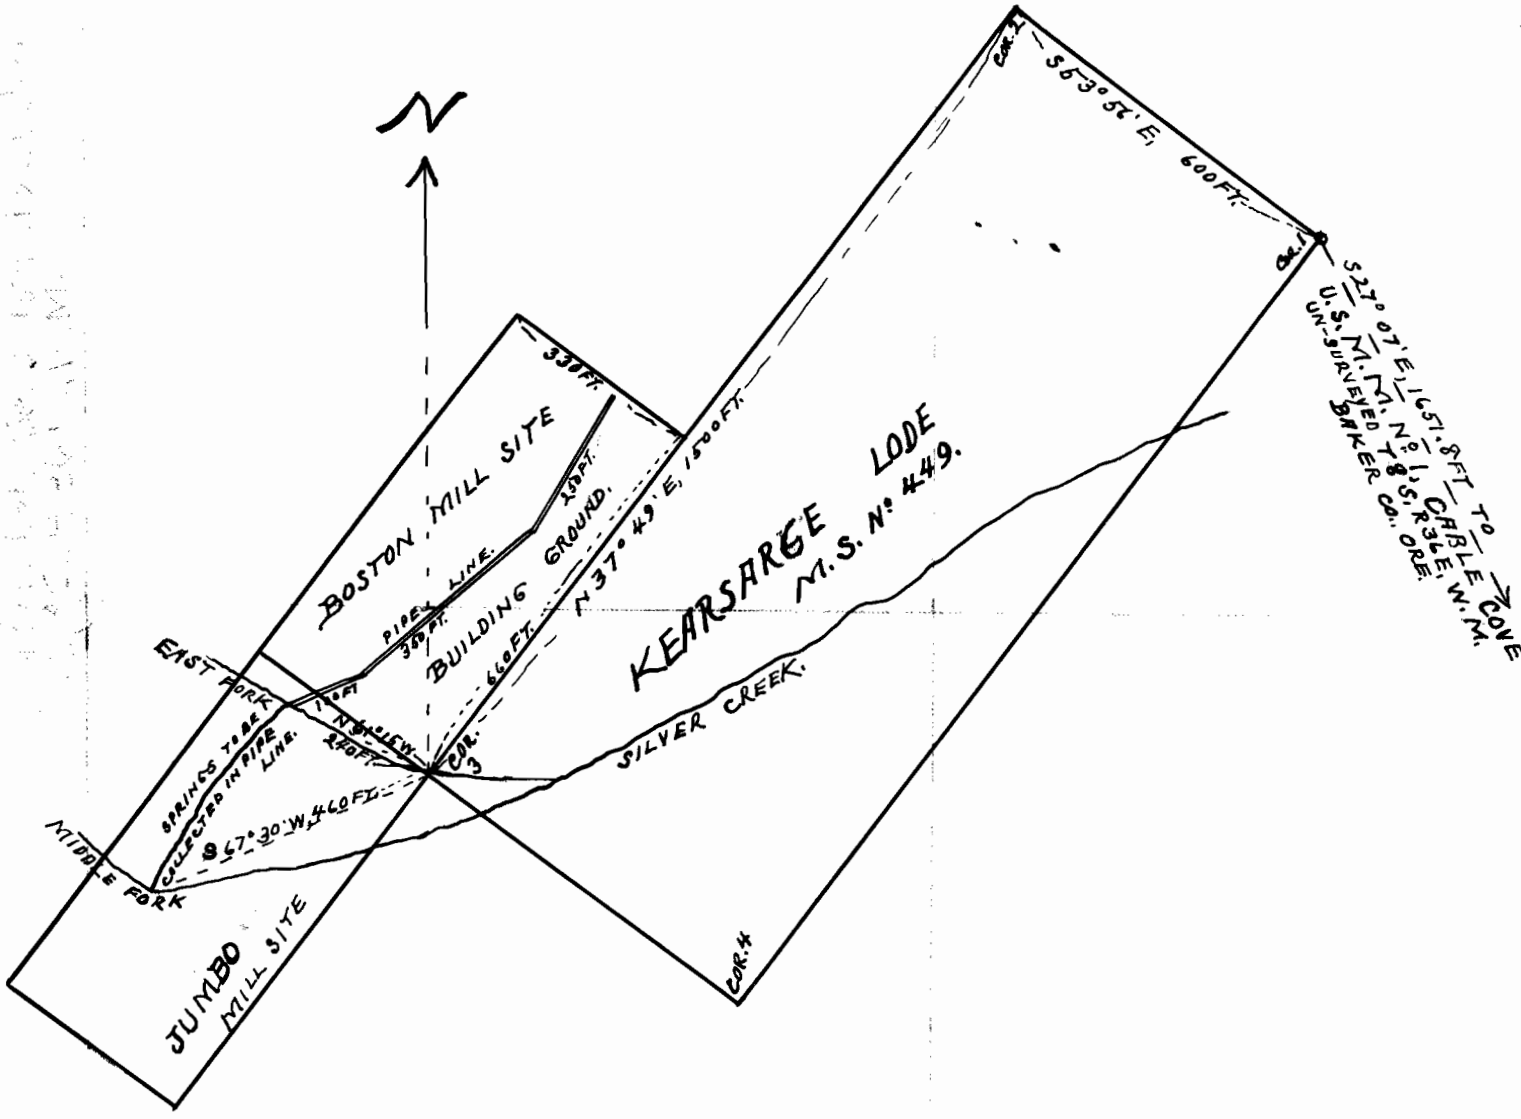


SKETCH

SHOWING

THE LOCATION OF THE

W.H.W. HAMILTON

PIPE LINE FOR WATER FOR

DOMESTIC USES

IN UN-SURVEYED T 8 S, R 36 E, W.M.

BAKER CO., OREGON.

SCALE, ONE INCH = 300 FT

SURVEY MADE, AUG. 6, 1929.

Ira L. Hoffman.
County Surveyor.

CERTIFICATE

I, IRA L. HOFFMAN OF BAKER, OREGON, DO HEREBY CERTIFY THAT THIS SKETCH WAS MADE FROM NOTES TAKEN DURING AN ACTUAL SURVEY MADE BY ME ON AUG. 6, 1929 + CERTIFIED PLATS AND THAT IT CORRECTLY REPRESENTS THE DATA SHOWN THEREON.

Ira L Hoffman,
REG. PROF. ENGINEER
OREGON No 90.
Nov. 8 1919.

12905

2198