


T. 34S.R.6W.W.M.

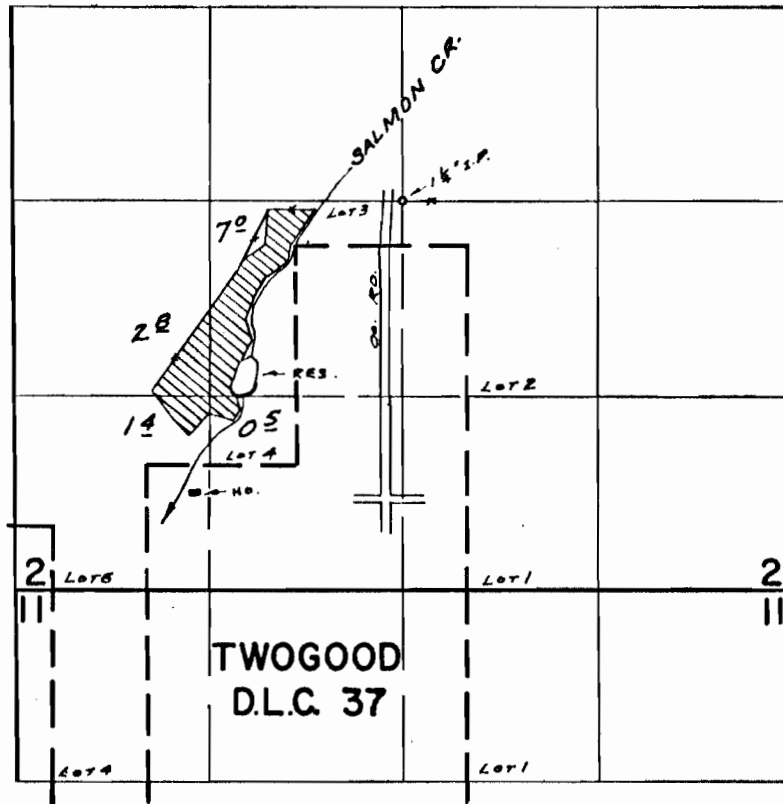

DIV. PT. LOC: 1070' W. & 1320' S. FROM CENTER SEC. 2

FINAL PROOF SURVEY
UNDER

Application No. ^{R-41875} 41867 Permit No. ^{R-4702} 31188
IN NAME OF

WILLIAM P. ANGELI & GEORGE H. ANGELI

Surveyed APR. 15, 1970, by R. MUCKEN.

● POD

POD Location:
1320' S, 1070' W of Center of Sec 2

**T34S R6W, WM,
JOSEPHINE COUNTY, OR**

----- Creek

 C-39786 IR 2-10-1966 "OFF"

 C-39786 (IS) 2-10-1966 "OFF"

 C-39786 (IS) 2-10-1966 "NO CHANGE"

 C-3378 IR 6-8-1917 "NO CHANGE"

 C-3378 IR 6-8-1917 "OFF"


 STORAGE RESERVOIR C-39785

— Section


----- Quarter Quarter

 DLC

 Tax Lot

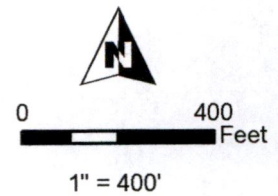

RENEWAL DATE 12/31/2022

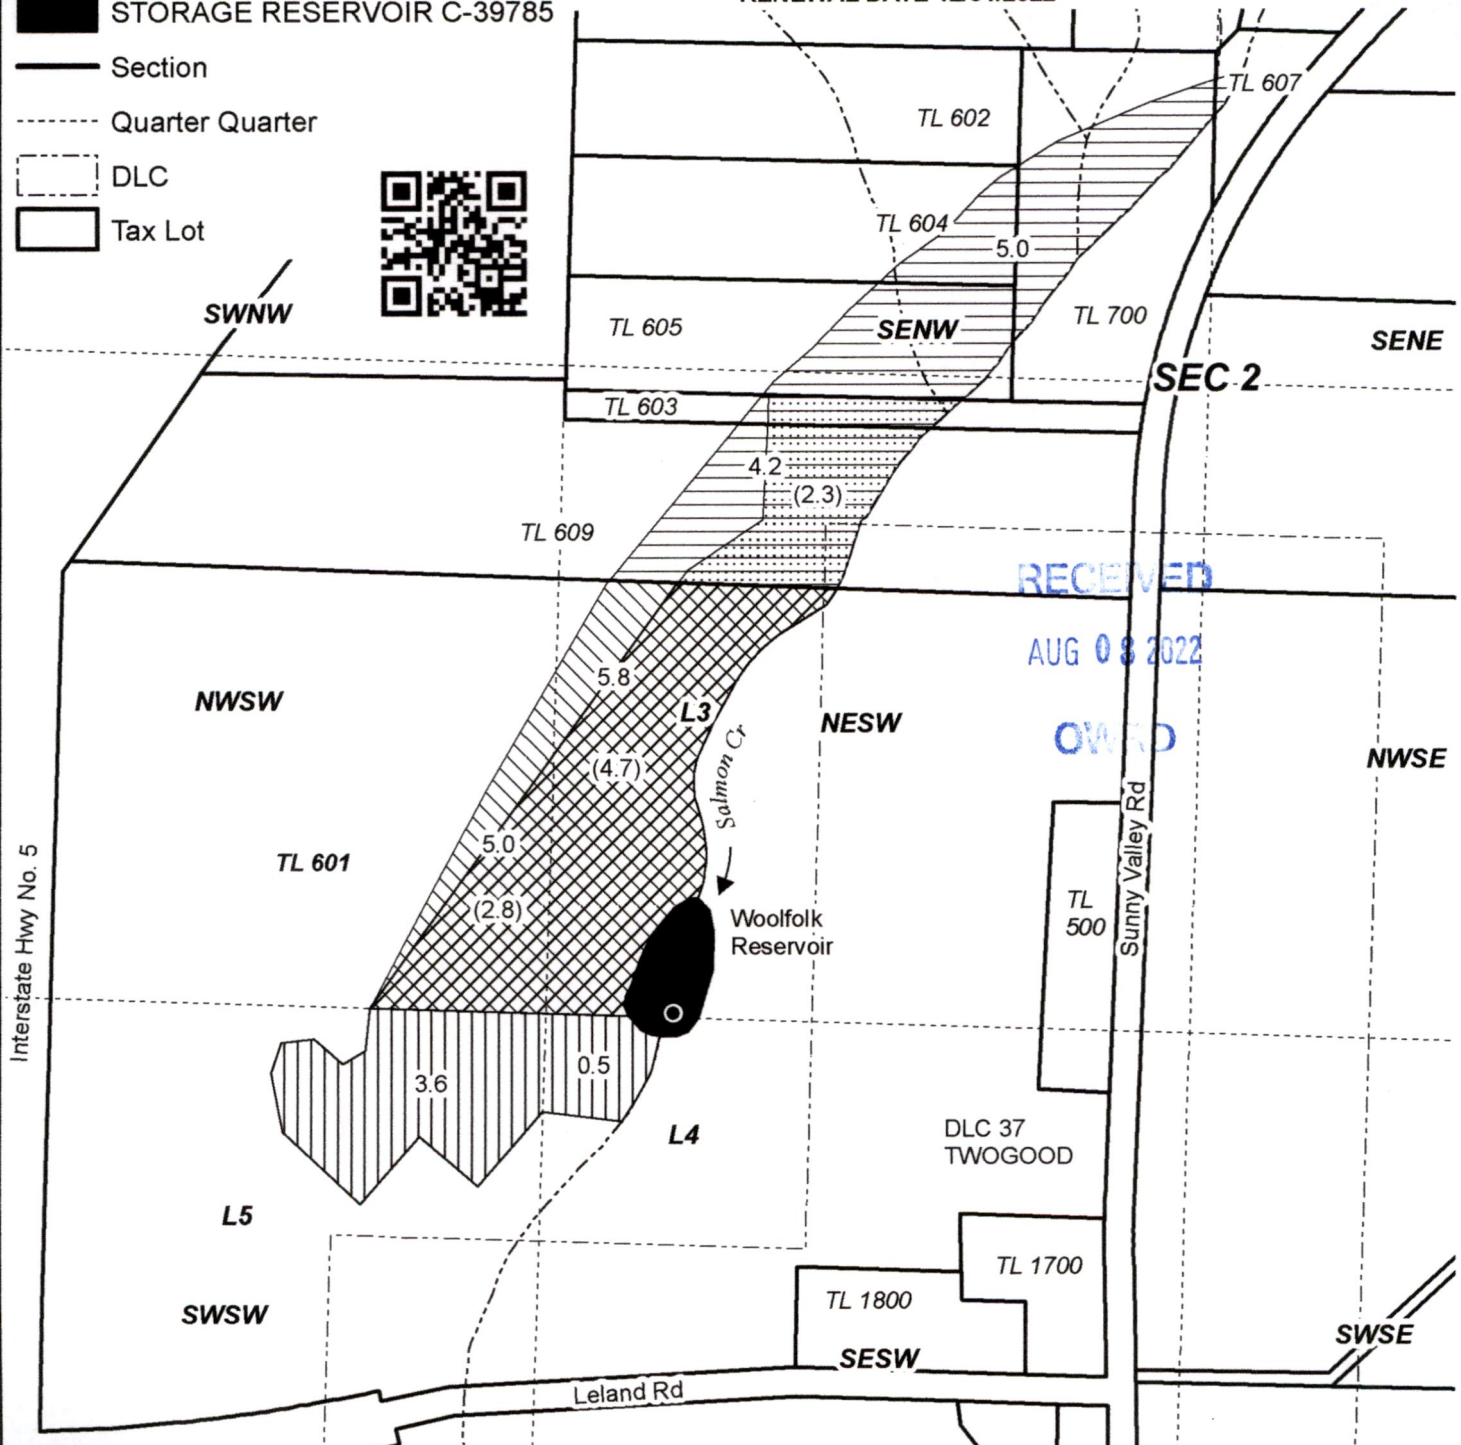

**Permanent Transfer "OFF" Map
Oregon Land Holdings, LLC**

C-3378 & C-39786

Date: 5/27/2022

This map is not intended
to provide legal dimensions
or locations of property
ownership lines.

WATER RIGHT SERVICES, LLC
PO BOX 1830, BEND, OR 97709
WWW.OREGONWATER.US CCB # 197121
johnshort@usa.com 541-389-2837