

Sec. 15

Top. 45
N. Aurora

R. 1 W

DEER CREEK

House

15

Reservoir




UNNAMED STREAM

To Donald

To Unnamed

To Woodburn

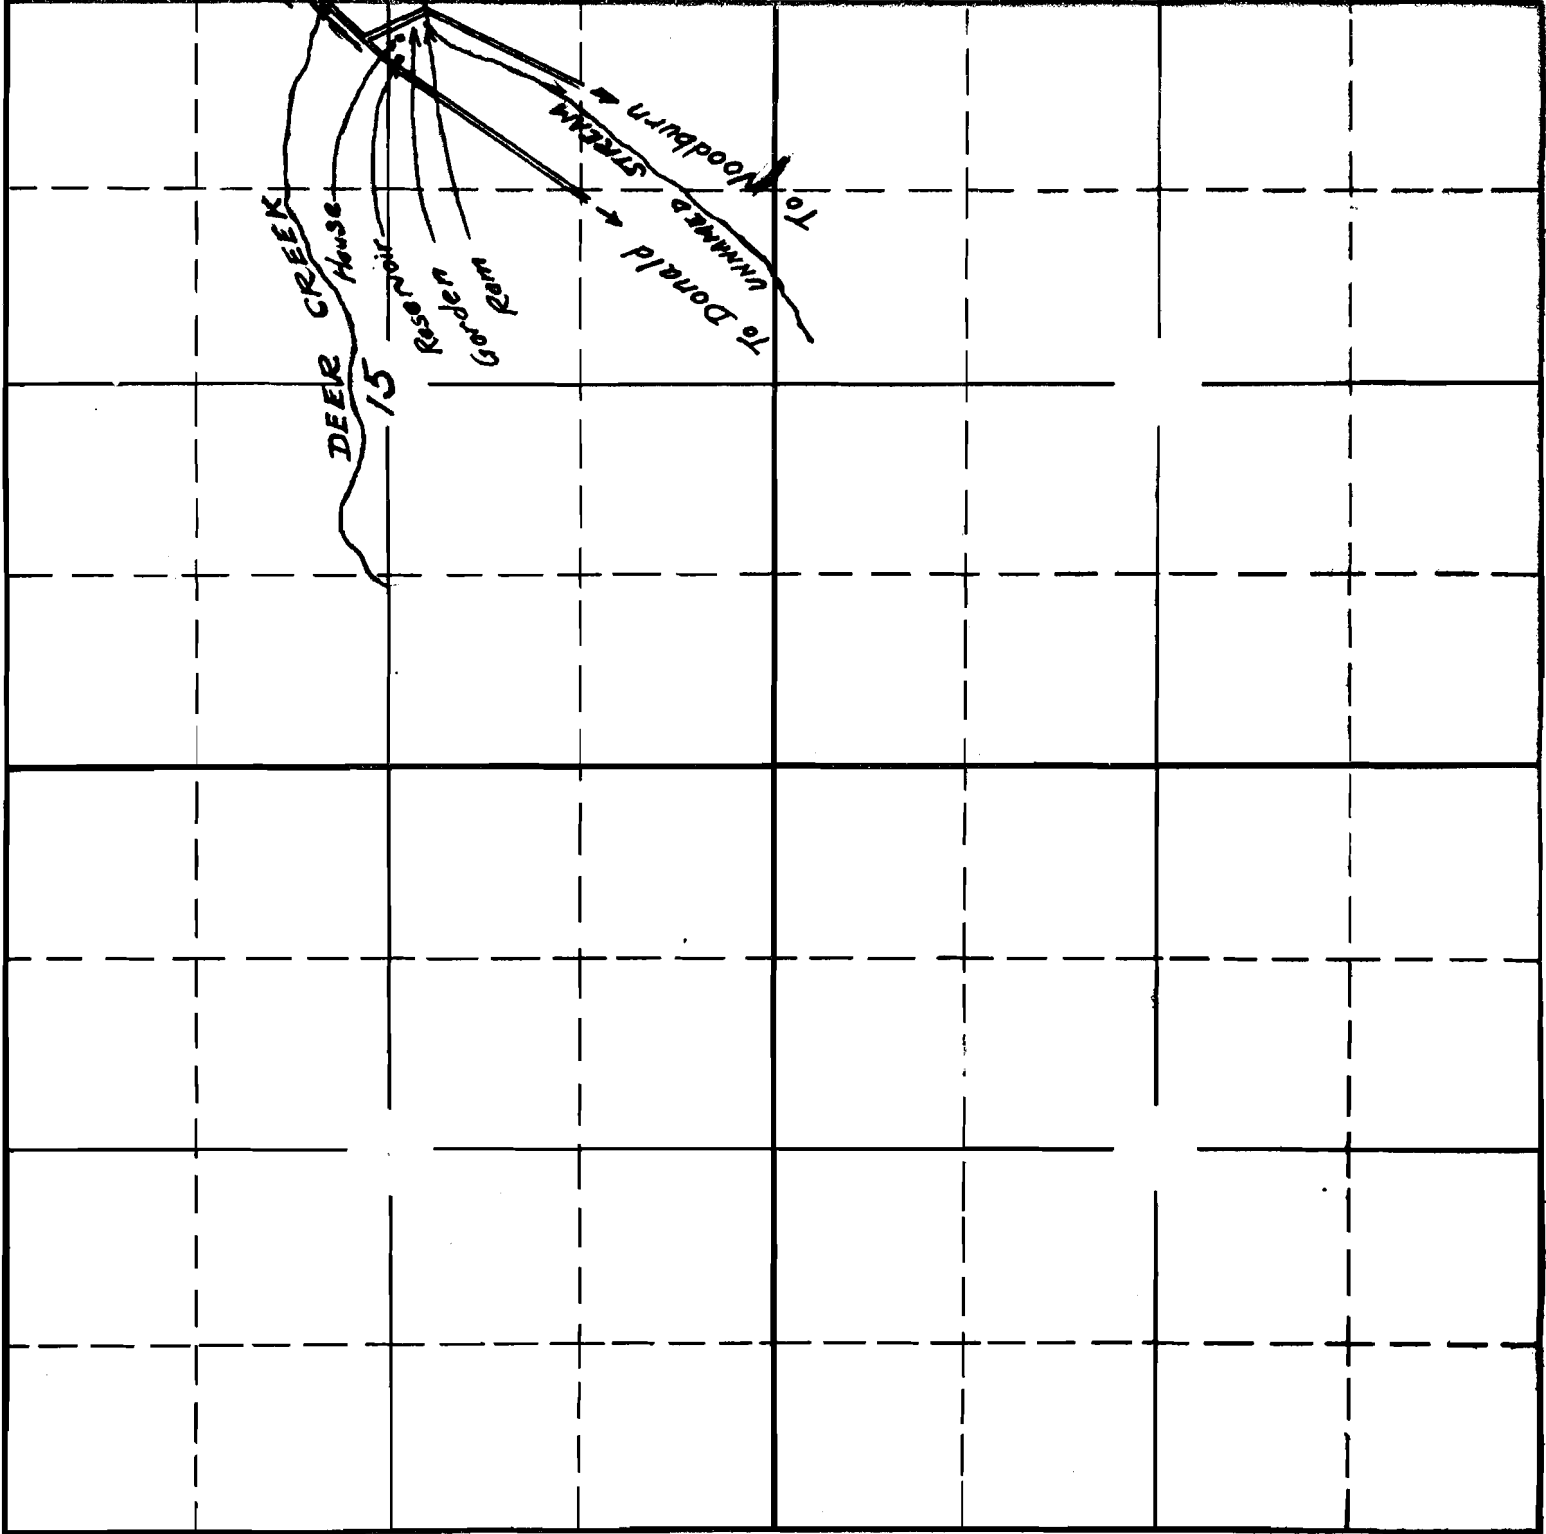

Application No. 13009
Permit No. 9286