


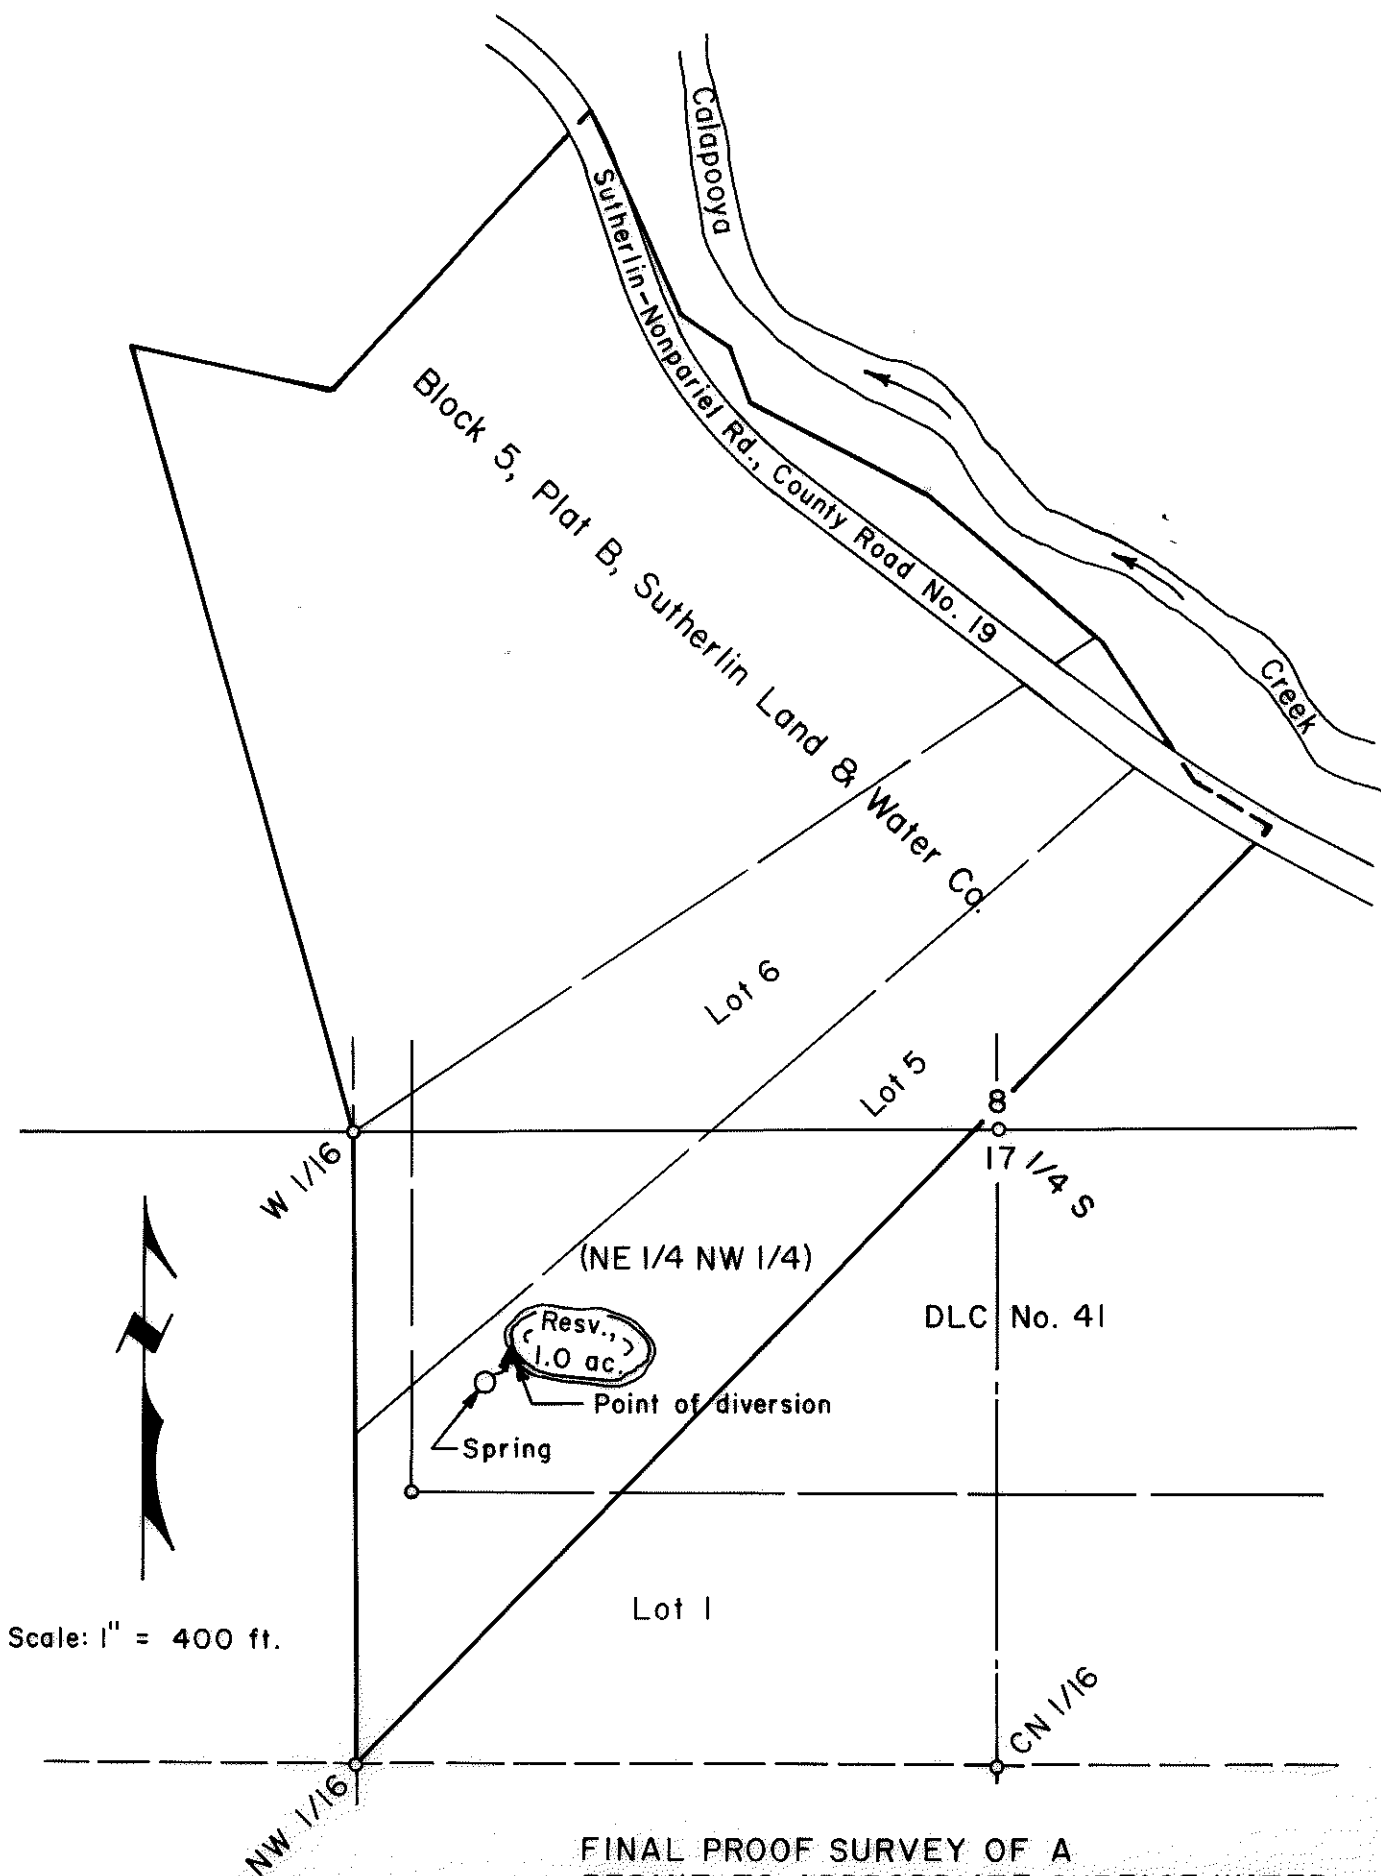

Scale: 1" = 400 ft.

Point of diversion is 470 ft. South
& 1,010 ft. West of the North 1/4
corner of Section 17.


FINAL PROOF SURVEY OF A
PERMIT TO APPROPRIATE SURFACE WATER
in Lot 5, Block 5, Plat B, Sutherlin Land &
Water Co. & in DLC No. 41 & in the NE 1/4
NW 1/4 of Section 17, T25S, R4W, W.M.,
Douglas County, Oregon

Application No. S-74521

Permit No. 52343

For: William E. & Mary L. Moon
6607 Nonpareil Road
Sutherlin, Oregon 97479

By: Shaner Engineering, Inc.
P.O. Box 1430
Roseburg, Oregon 97470

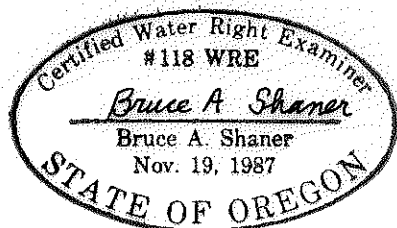

RECEIVED

JUL 31 1998

WATER RESOURCES DEPT.
SALEM, OREGON

July 31, 1998