

RECEIVED



AUG 08 2000

WATER RESOURCES DEPT.
SALEM, OREGON

FINAL PROOF SURVEY MAP
IN THE NAME OF
WALTER R. DICKOVER
JERRY W. REDENIUS
COMMON VENTURES, INC.

APPLICATION R-74486 PERMIT R-12092
APPLICATION S-74487 PERMIT 52974

SECTION 32, TOWNSHIP 28 SOUTH, RANGE 7 WEST, W.M.

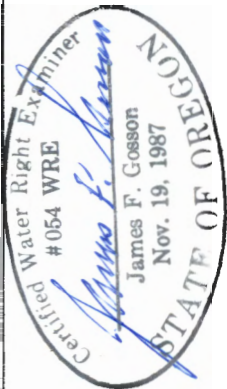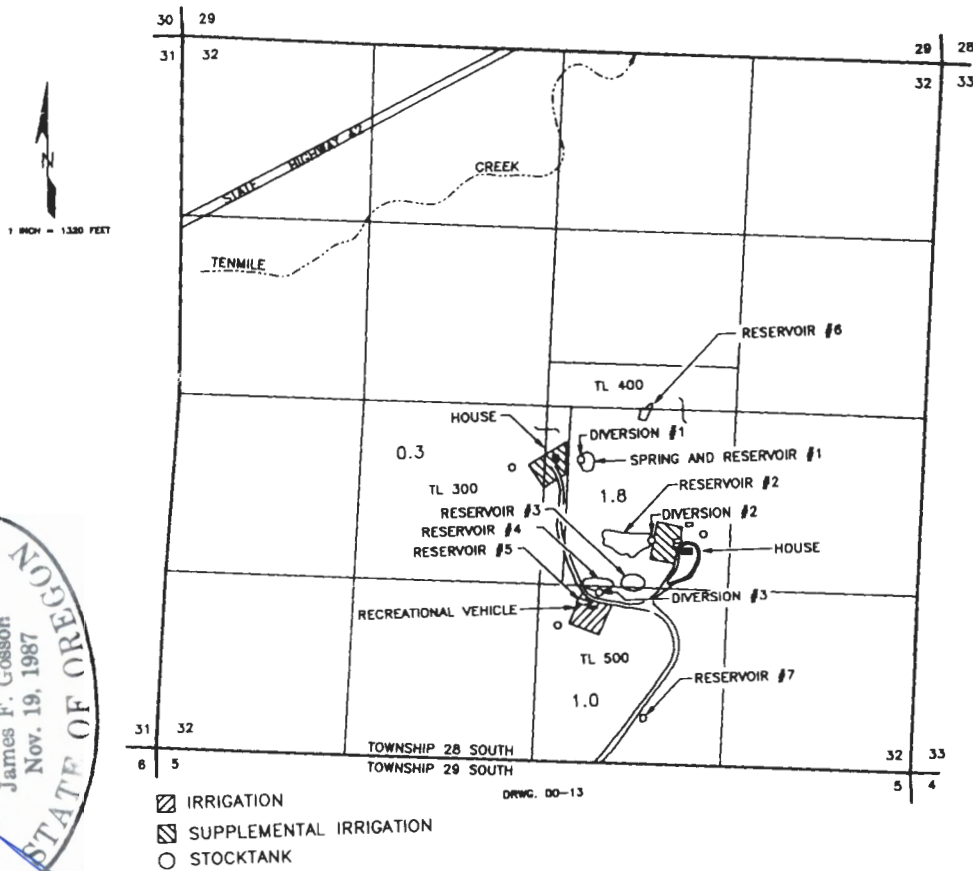

DIVERSION	FT. N.	FT. W.	1/4 1/4	
POD #1	2240	2180	NW SE	ALL BEING FROM THE SOUTHEAST COR-
POD #2	1670	1710	NW SE	NER OF SECTION 32, TOWNSHIP 28 SOUTH,
POD #3	1320	2070	SW SE	RANGE 7 WEST, W.M., DOUGLAS COUNTY.

THE PURPOSE OF THIS MAP IS TO IDENTIFY THE LOCATION OF THE WATER RIGHT. IT IS NOT INTENDED TO PROVIDE INFORMATION RELATIVE TO THE LOCATION OF PROPERTY OWNERSHIP BOUNDARY LINES.