

FINAL PROOF MAP

TO CHANGE PLACE OF USE AND
POINTS OF APPROPRIATION

FOR T-11847


J SPEAR RANCH CO.

RECEIVED BY OWRD

OCT 11 2017

SALEM, OR

SECTION 21, TOWNSHIP 34 SOUTH, RANGE 19 EAST, W.M.
TAX LOT: 1900 LAKE COUNTY, OREGON

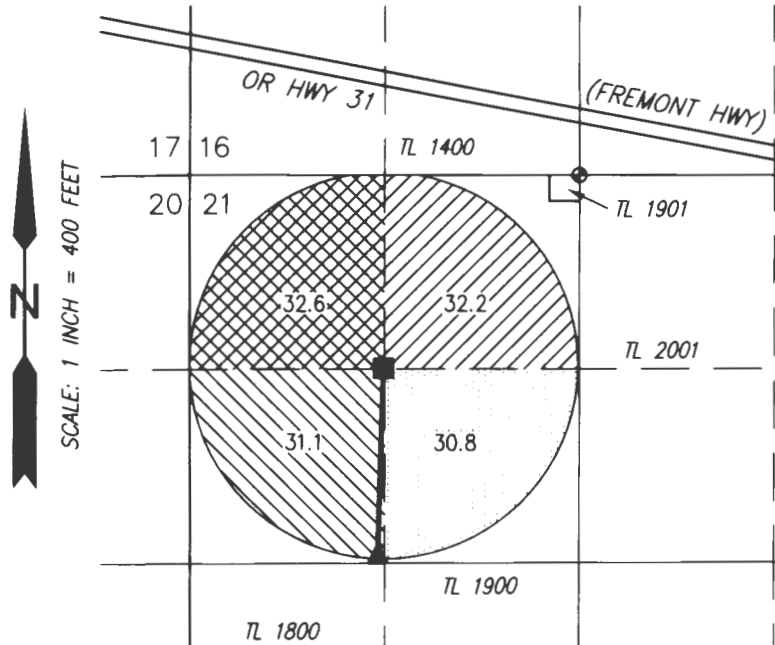

▲ POA #2 (GILSON)


EXISTING WELL (LAKE 4450)
LOCATED 2600' SOUTH & 1290'
EAST FROM THE NW CORNER
SECTION 21.

METER IS LOCATED ON THE
DELIVERY PIPE 6 FEET NORTH OF
THE WELL


■ POA #3

EXISTING WELL (LAKE 52605)
LOCATED 1300' SOUTH & 1290' EAST
FROM THE NW CORNER SECTION 21.


METER IS LOCATED ON THE DELIVERY
PIPE 6 FEET NW OF THE WELL

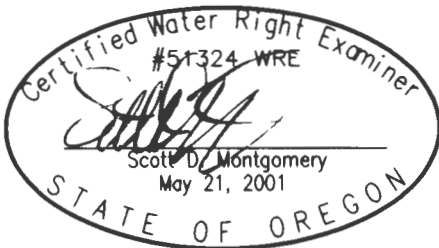


RENEWAL DATE: 12/31/2018

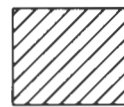


32.2 ACRES PRIMARY RIGHTS
FROM C#28433 (G-158) &
SUPPLEMENTAL RIGHTS FROM
C#80144 (G-5670), AS SHOWN

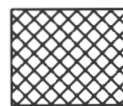

32.6 ACRES PRIMARY RIGHTS
FROM C#28433 (G-158) &
SUPPLEMENTAL RIGHTS FROM
C#80144 (G-5670) & C#83162
(G-10926), AS SHOWN

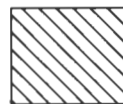

31.1 ACRES PRIMARY RIGHTS
FROM C#28433 (G-158) &
SUPPLEMENTAL RIGHTS FROM
C#83162 (G-10926), AS SHOWN

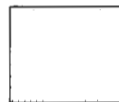

30.8 ACRES PRIMARY RIGHTS
FROM C#28433 (G-158), AS
SHOWN

THIS MAP IS FOR THE PURPOSE OF LOCATING A WATER
RIGHT ONLY AND HAS NO INTENT TO PROVIDE LEGAL
DIMENSIONS OR THE LOCATION OF PROPERTY LINES

PREPARED FOR:

J SPEAR RANCH CO.
39650 CLOVER FLAT RD
PAISLEY, OR 97636

PREPARED BY:



ALL POINTS ENGINEERING AND SURVEYING, INC.
P.O. BOX 767
(541) 548-5833
TERREBONNE, OR 97760
www.APEandS.com