



CLAIM OF BENEFICIAL USE MAP
NW 1/4 Section 24, T.29S. R.17E., W.M.
 Lake County, Oregon

Transfer 12089

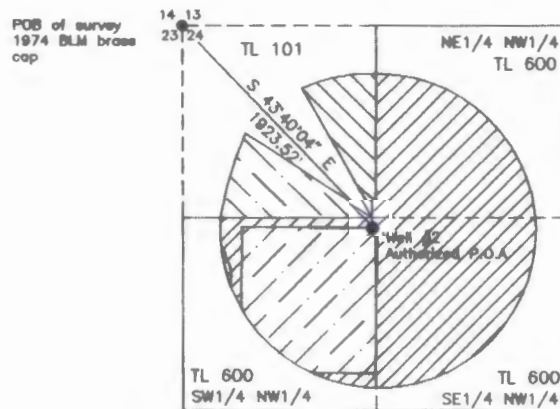


SCALE
 1" = 1320'



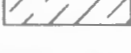-  5.89 Acres irrigated
Transfer 12089
-  7.34 Acres irrigated
Transfer 11911
-  46.98 Acres irrigated
Certificate 91128
-  20.52 Acres irrigated
Certificate 91127

Prepared for: Ernest D. & Dixie Shuffield
 Chaylon & Amber Shuffield
 Prepared by: Sundet & Associates
 P.O. Box 1228
 Lakeview, OR 97630
 541-947-4458

May 2016 DR #1444

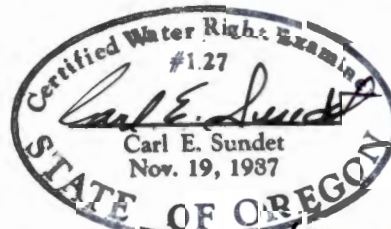

This map is for the purpose of identifying the location of the water right only and is not intended to provide legal dimensions or location of property ownership lines.

Revised 6/21/17 RECEIVED BY OWRD

FEB 27 2017

SALEM, OR