


# Claim of Beneficial Use T-11984 T.5S.,R.1W.,W.M.

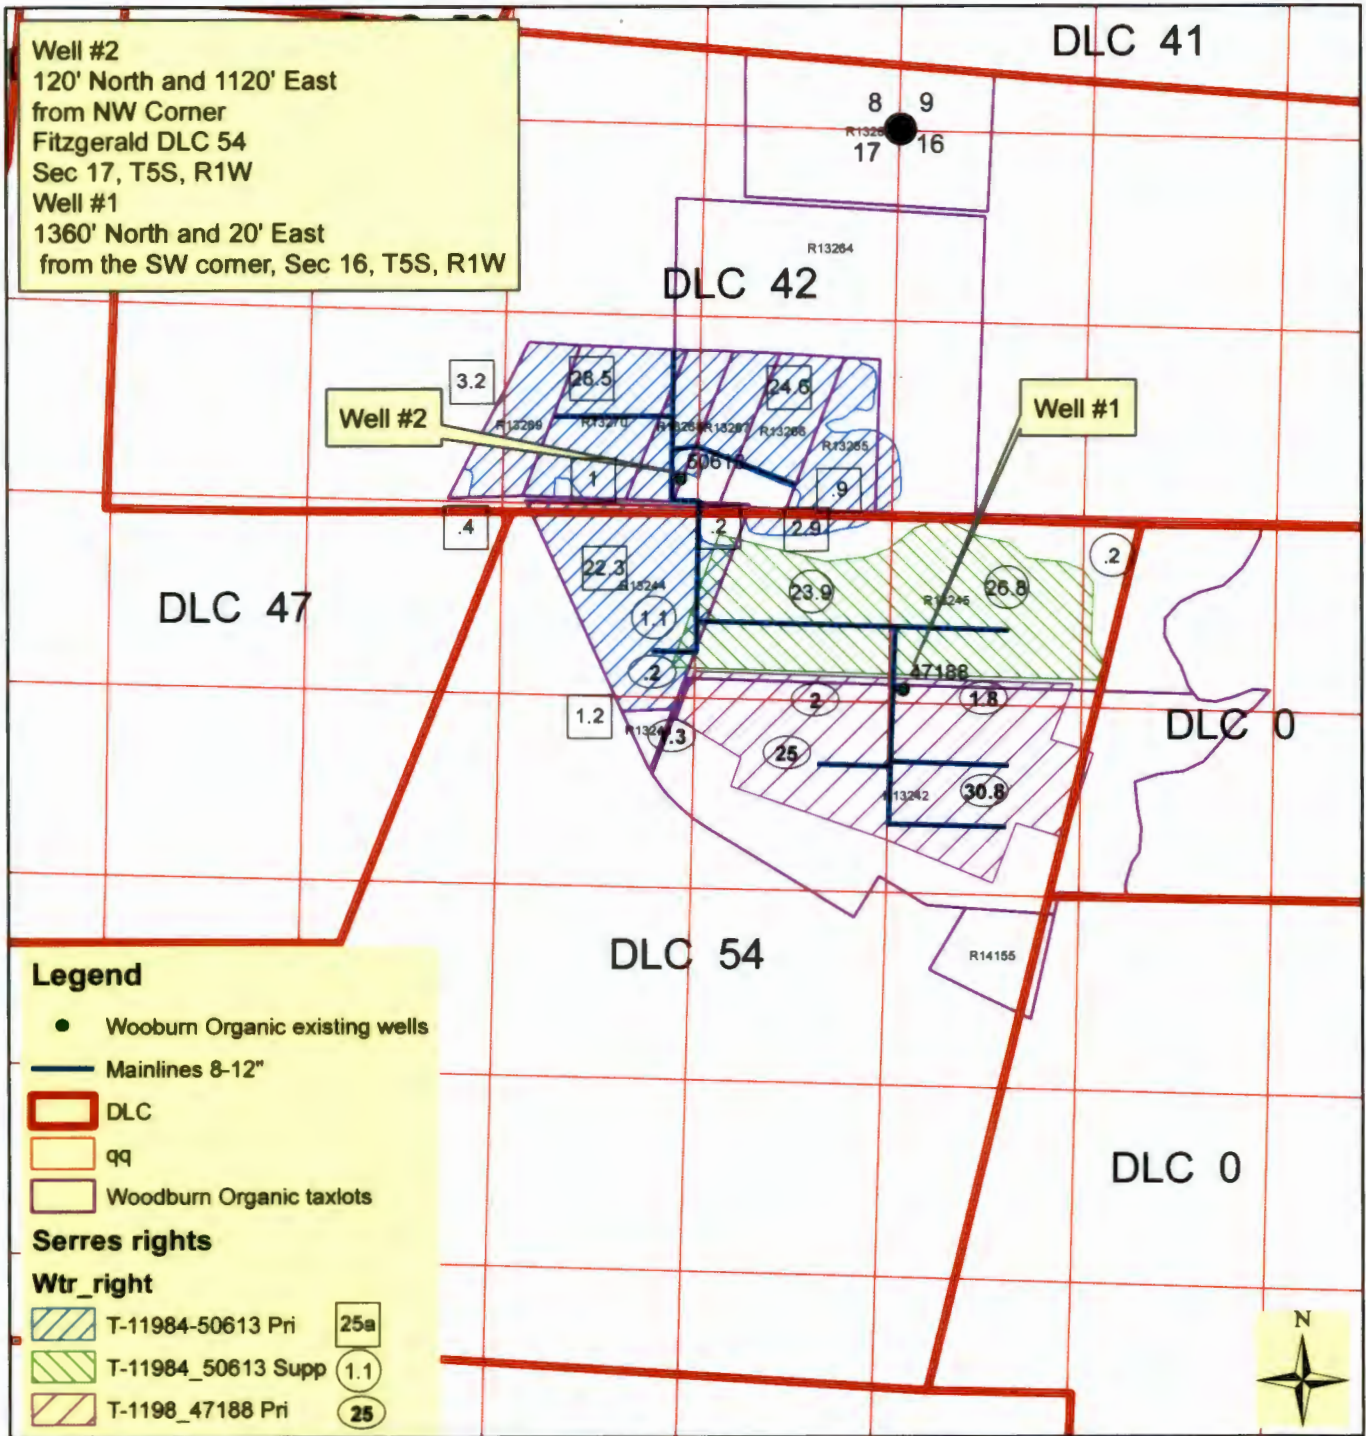

0 330 660 1,320 Feet

map prepared by McGill & Stevenson

This map is not intended to provide legal dimensions or locations of property ownership



EXPIRES: 12/31/2018