
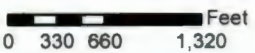


Claim of Beneficial Use T-11984 T.5S.,R.1W.,W.M.

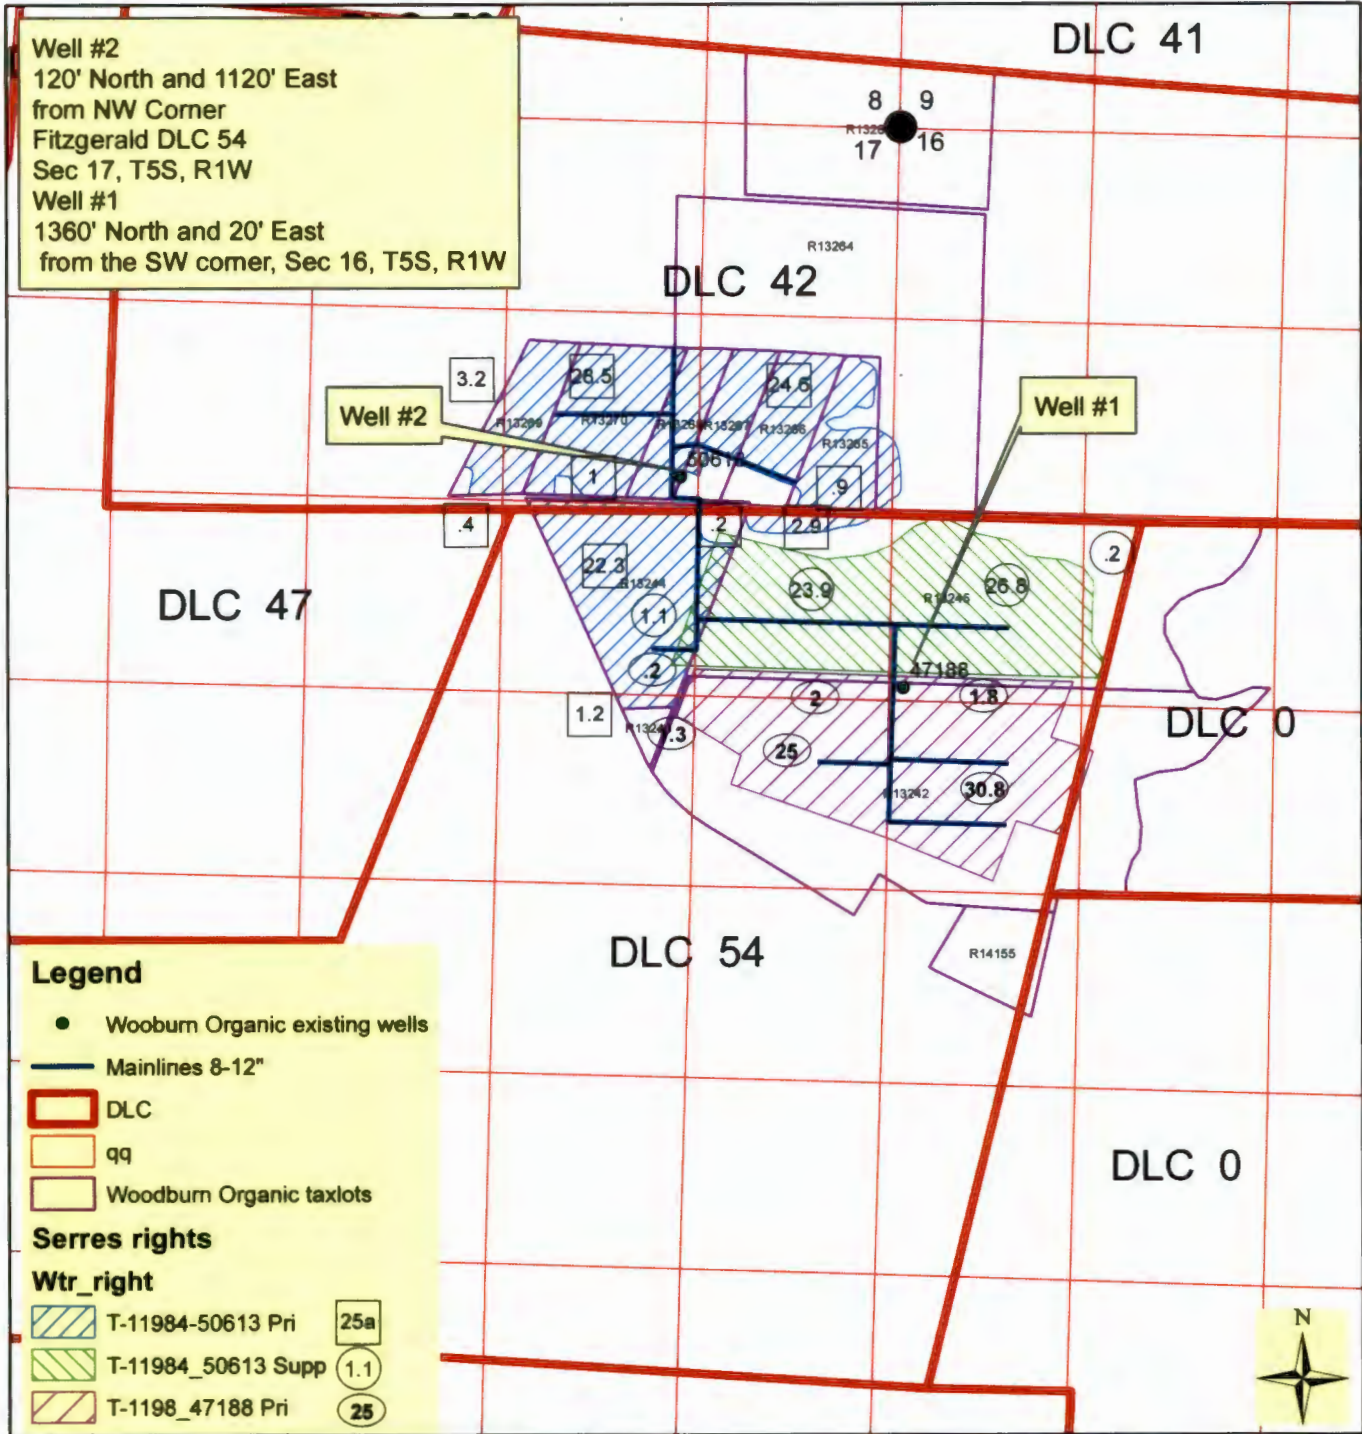

map prepared by McGill & Stevenson

This map is not intended to provide legal dimensions or locations of property ownership

CERTIFIED WATER RIGHT EXAMINER
 30680
William E. McGill
 WILLIAM E. MCGILL
 MAY 3, 2011
 STATE OF OREGON

EXPIRES: 12/31/2018

RECEIVED
MAY 3 2011
OW