


# CLAIM OF BENEFICIAL USE

TL 300, 301 AND 202,  
 IN THE SE 1/4 AND NE 1/4 OF SECTION 12, T.3.S., R.3.E., W.M.  
 EAGLE CREEK, CLACKAMAS COUNTY, OREGON  
 APPLICATION NO. G-17197 PERMIT NO. G-16966

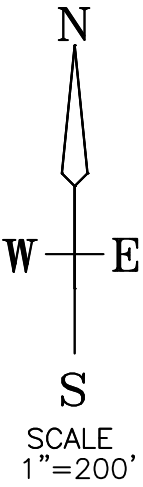


CLACKAMAS RIVER

SW 1/4 NE 1/4  
 SECTION 12  
 6.58 ACRES

NW 1/4 SE 1/4  
 SECTION 12  
 1.56 ACRES

SE 1/4 NE 1/4  
 SECTION 12  
 2.60 ACRES


NE 1/4 SE 1/4  
 SECTION 12  
 1.62 ACRES

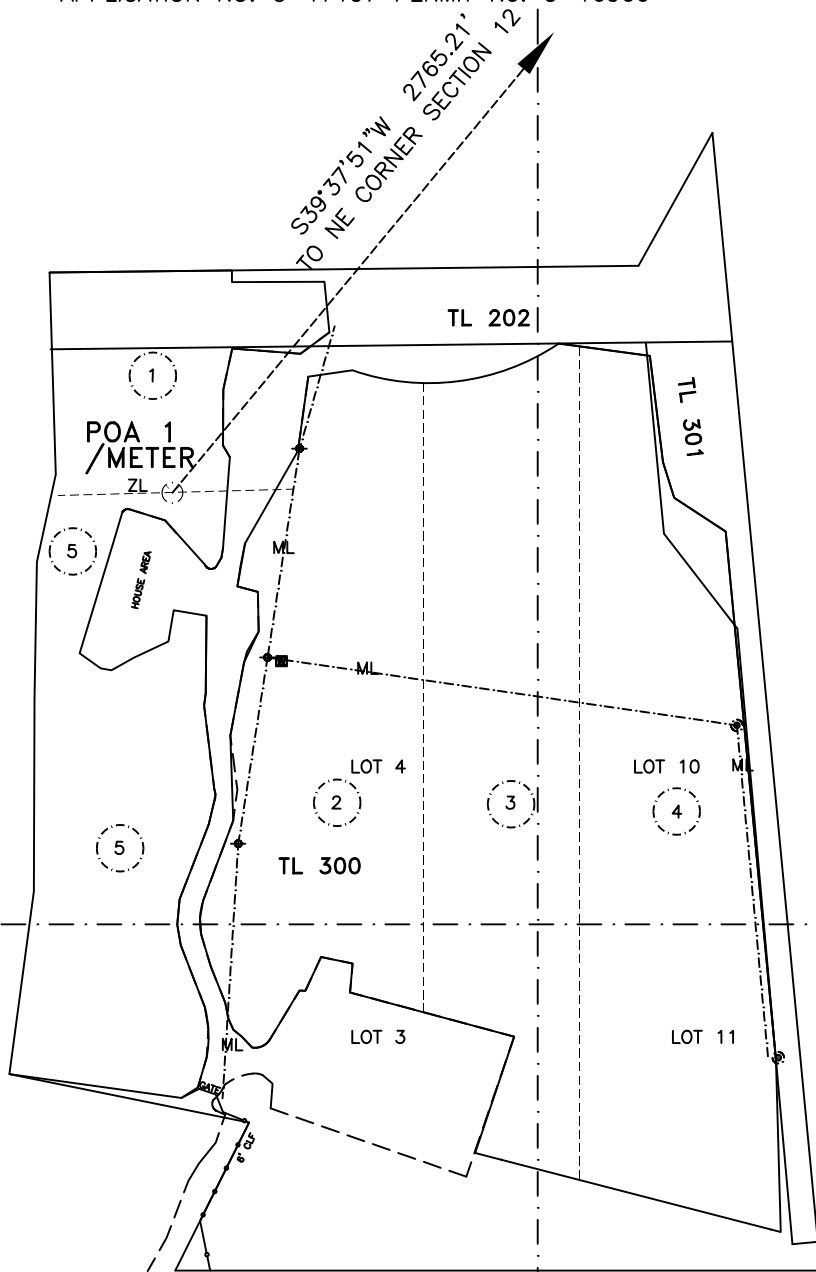

- = STAND PIPE
- = CONTROL VALVE
- = WELL HEAD
- = PVC PIPE
- = ZONE NUMBER
- ML = MAIN LINE
- ZL = ZONE LINE
- QS = QUARTER SECTION LINE

NOTE: THIS MAP IS NOT INTENDED TO PROVIDE LEGAL DIMENSIONS OR LOCATIONS OF PROPERTY OWNERSHIP.

WILLIAM JABS  
 27525 SE STARR RD  
 EAGLE CREEK, OREGON 97022

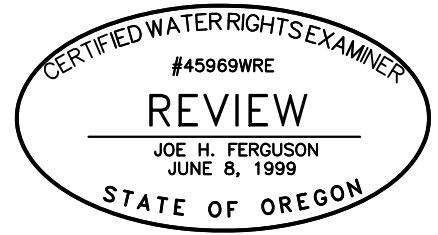


**Ferguson Land Surveying, Inc.**  
 646 SE 106TH AVE. PORTLAND, OR 97216  
 Phone (503) 408-0601

SHEET NO. 1 OF 1  
 JOB NO. 19-108  
 DRAFTED: 6/26/2023

# CLAIM OF BENEFICIAL USE

TL 300, 301 AND 202,  
 IN THE SE 1/4 AND NE 1/4 OF SECTION 12, T.3.S., R.3.E., W.M.  
 EAGLE CREEK, CLACKAMAS COUNTY, OREGON  
 APPLICATION NO. G-17197 PERMIT NO. G-16966

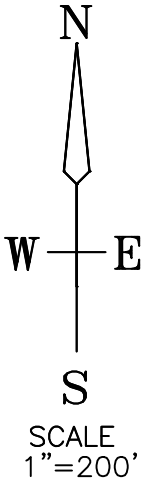


CLACKAMAS RIVER

SW 1/4 NE 1/4  
 SECTION 12  
 6.58 ACRES

NW 1/4 SE 1/4  
 SECTION 12  
 1.56 ACRES

SE 1/4 NE 1/4  
 SECTION 12  
 2.60 ACRES


NE 1/4 SE 1/4  
 SECTION 12  
 1.62 ACRES

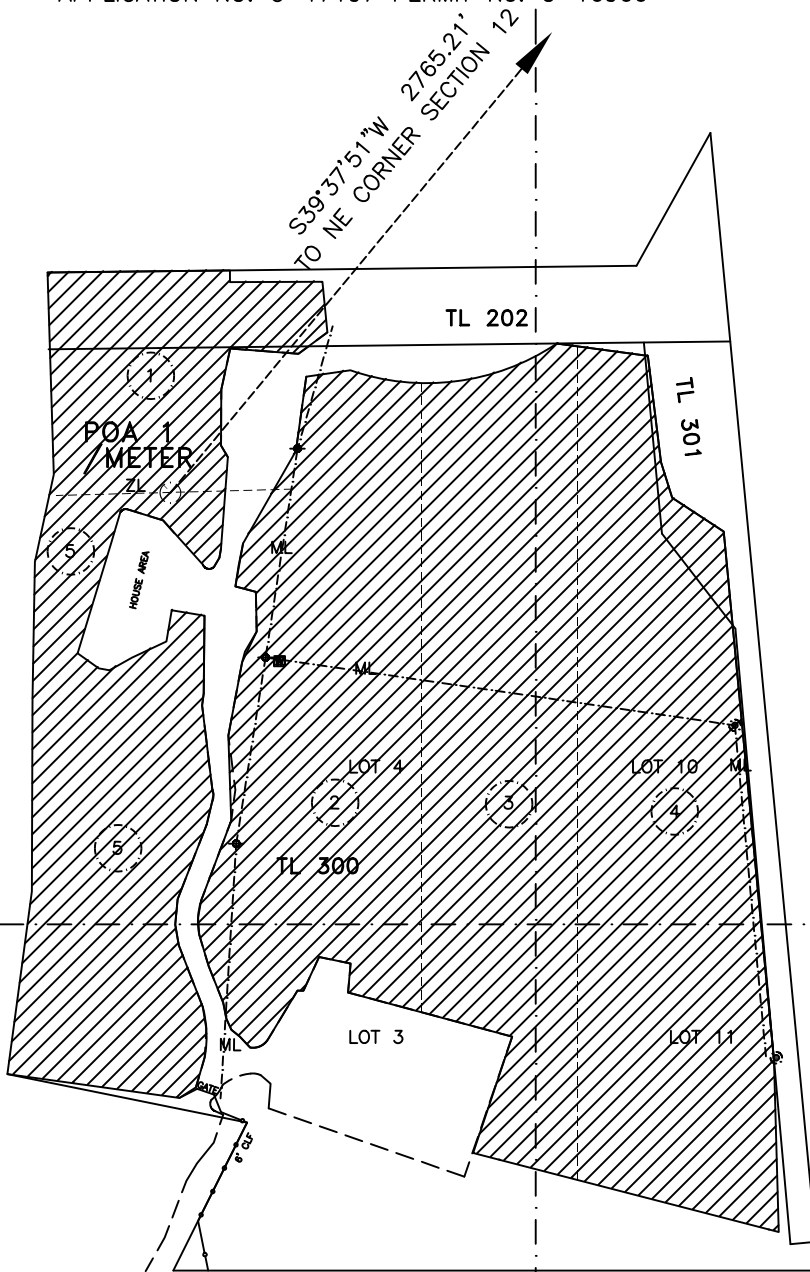

- ⊕ = STAND PIPE
- ⊞ = CONTROL VALVE
- ⊙ = WELL HEAD
- ⊙ = PVC PIPE
- (X) = ZONE NUMBER
- ML = MAIN LINE
- ZL = ZONE LINE
- QS = QUARTER SECTION LINE

NOTE: THIS MAP IS NOT INTENDED TO PROVIDE LEGAL DIMENSIONS OR LOCATIONS OF PROPERTY OWNERSHIP.

WILLIAM JABS  
 27525 SE STARR RD  
 EAGLE CREEK, OREGON 97022

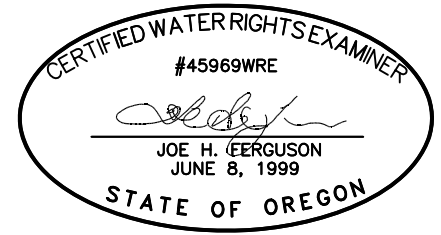

**Ferguson Land Surveying, Inc.**  
 646 SE 106TH AVE. PORTLAND, OR 97216  
 Phone (503) 408-0601

SHEET NO. 1 OF 1  
 JOB NO. 19-108  
 DRAFTED: 6/26/2023