


Transfer Application - Certificate 51276

Kongsore, Bente

Township 19S, Range 4W, W.M.

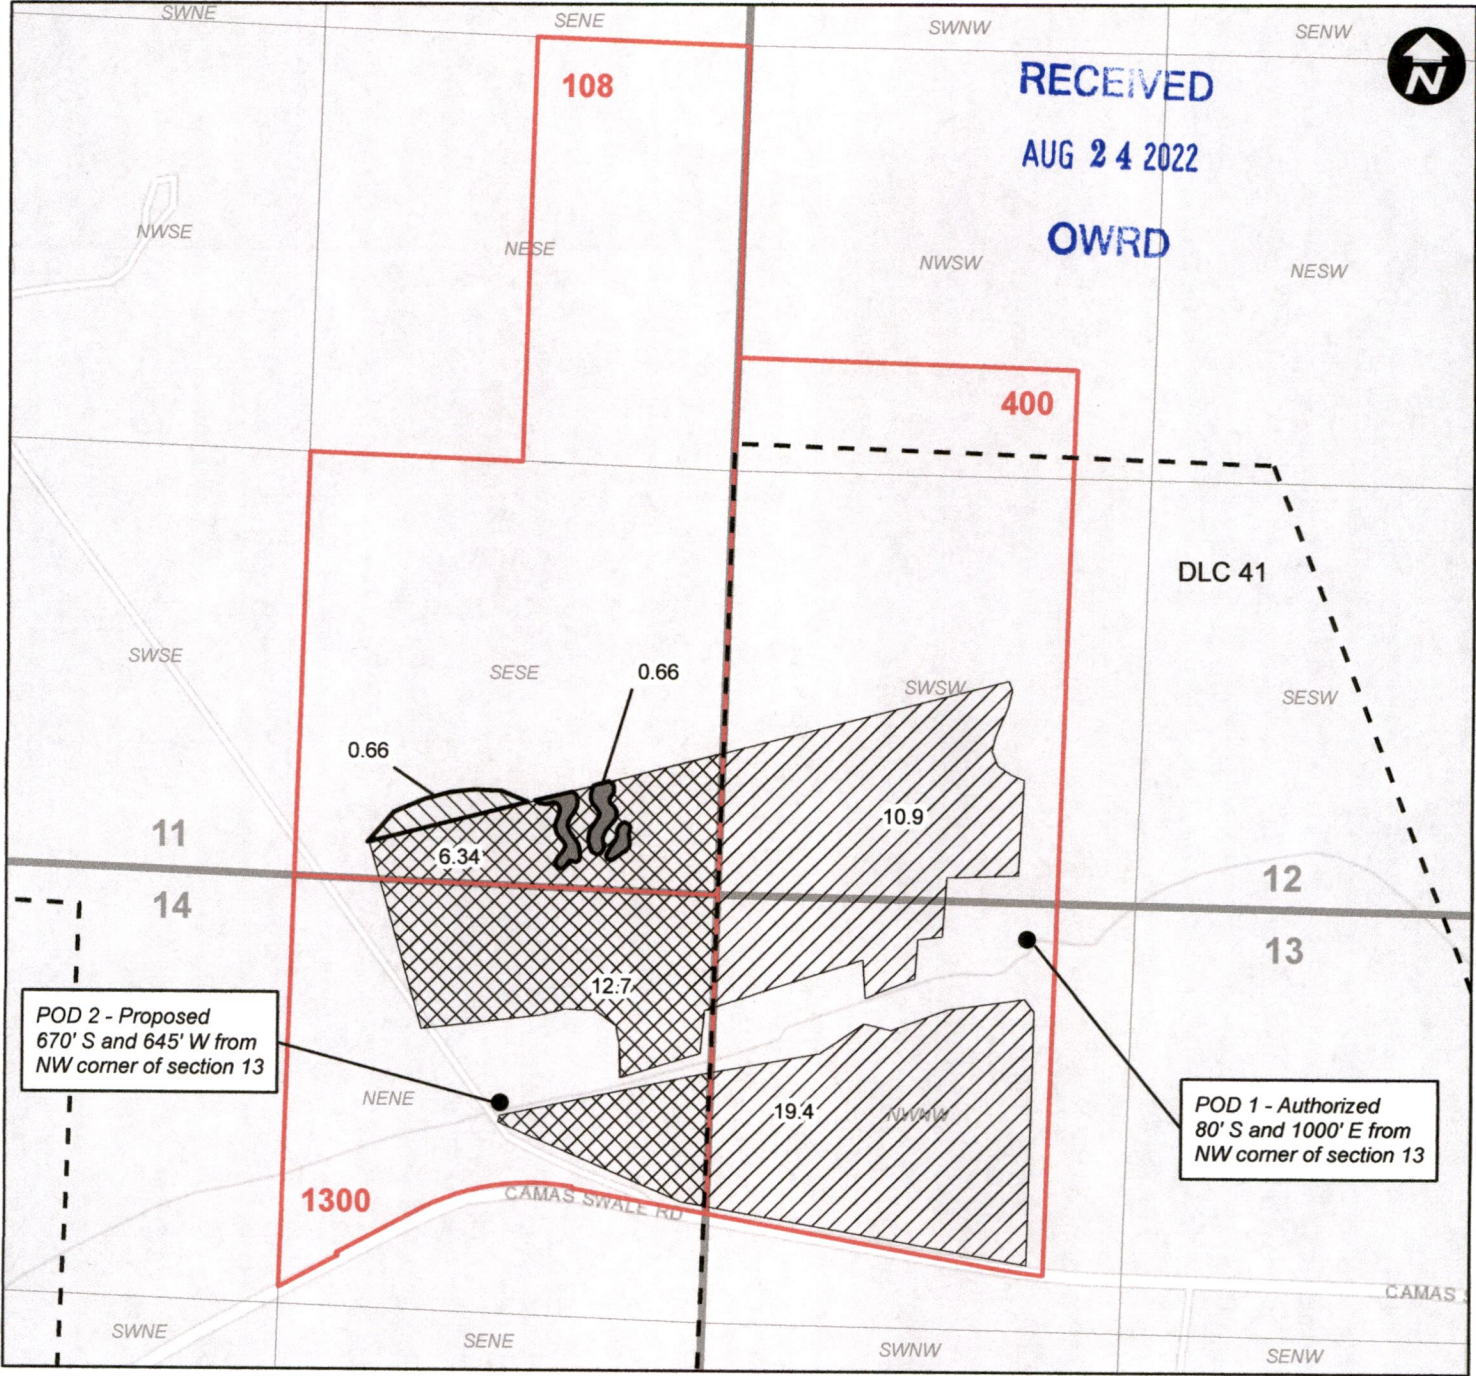


Legend

- DLC
- Tax Lot
- Transfer From
- Transfer To (& POD Change)
- POD Change Only
- Cert. 51276 No Change



T.19S.,R.4W.,W.M.

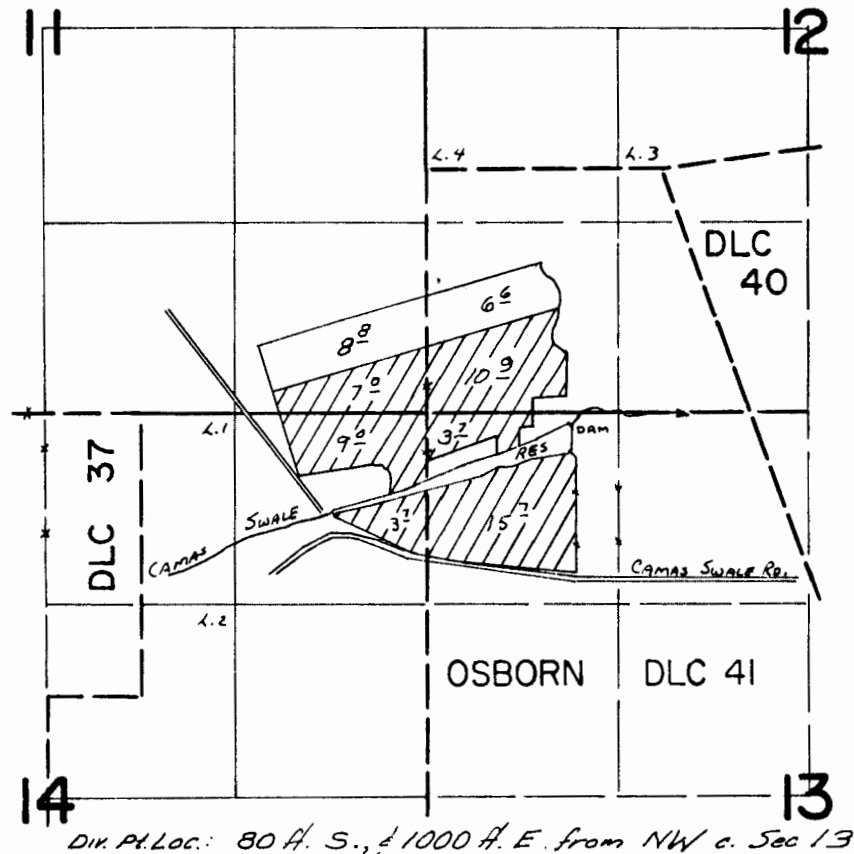

Dir. Pt. Loc.: 80 ft. S., & 1000 ft. E. from NW c. Sec 13

FINAL PROOF SURVEY
UNDER

Application No. R-45398 Permit No. R-5337
45207 33772
IN NAME OF

KENT & BRYCE OLSON

Surveyed April 15, 1975, by L. T. R. 11
MAY 9, 1980 S. Brown