


# FINAL PROOF MAP

TO ADD PLACE OF USE &  
POINT OF APPROPRIATION  
FOR APPLICATION G-17250

TAX LOTS: 100 & 101 IN SECTION 9,  
TOWNSHIP 24 SOUTH, RANGE 30 EAST, W.M.

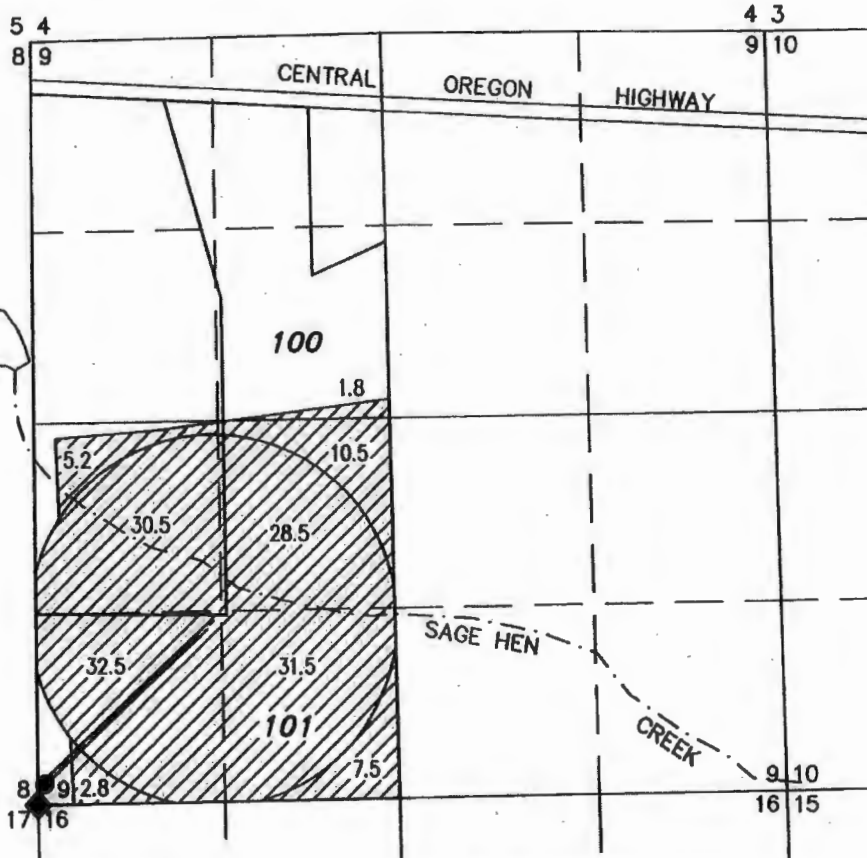


— DELIVERY PIPE



RENEWAL DATE: 12/31/2022

**#2 (HARN 51622/HARN 51839)**

LOCATED IN THE SW 1/4 SW 1/4 SECTION 9, T24S  
R30E, W.M. AND NORTH 17°17'56" EAST 157.66 FEET  
FROM THE SW CORNER OF SECTION 9.  
FLOW METER IS LOCATED 4 FEET NORTH OF WELL ON  
THE DELIVERY PIPE.

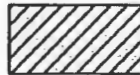

150.8 ACRES '1R' RIGHTS FROM #2  
PER G-16936, AS SHOWN.

THIS MAP IS FOR THE PURPOSE OF LOCATING A WATER RIGHT ONLY AND HAS NO  
INTENT TO PROVIDE LEGAL DIMENSIONS OR THE LOCATION OF PROPERTY LINES.

PREPARED FOR:

SHAUN MARTIN  
P.O. BOX 266  
BURNS, OR 97720

PREPARED BY:



ALL POINTS ENGINEERING AND SURVEYING, INC.  
P.O. BOX 767 TERREBONNE, OR 97760  
(541) 548-5833 www.APEandS.com