


Claim of Beneficial Use - Braun - Transfer T-13066




Township 12S, Range 4W, W.M.

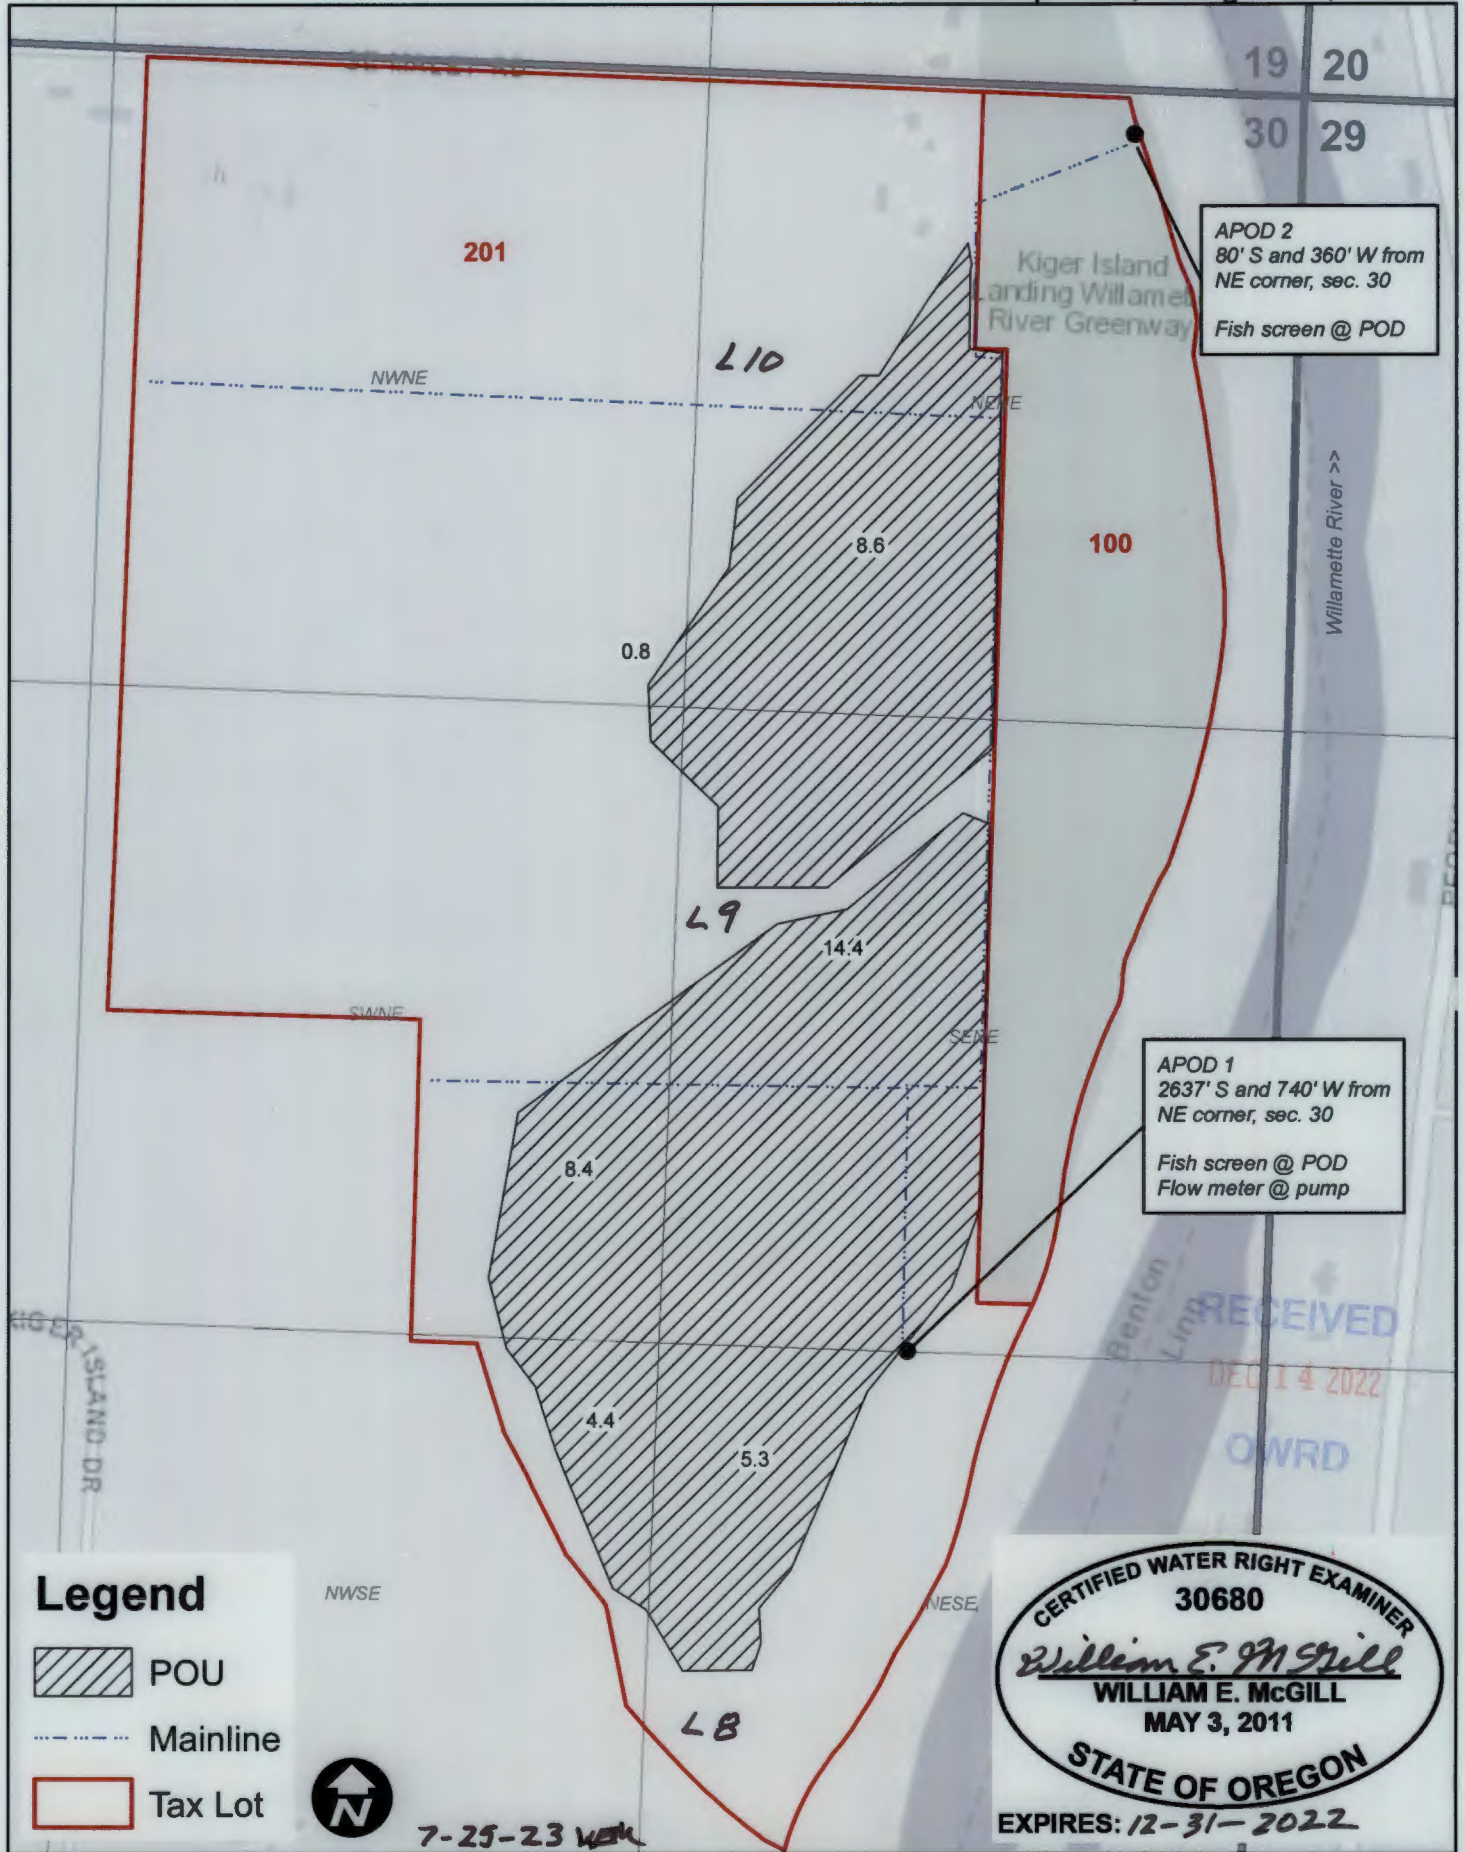


APOD 2
80' S and 360' W from
NE corner, sec. 30
Fish screen @ POD

APOD 1
2637' S and 740' W from
NE corner, sec. 30
Fish screen @ POD
Flow meter @ pump

Legend

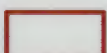-  POU
-  Mainline
-  Tax Lot

CERTIFIED WATER RIGHT EXAMINER
30680
William E. McGill
WILLIAM E. MCGILL
MAY 3, 2011
STATE OF OREGON
EXPIRES: 12-31-2022

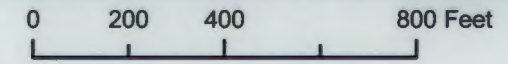

This map is not intended to provide legal dimensions or locations of property ownership lines.