

FINAL PROOF SURVEY MAP

IN THE NAMES OF MARION A. OR CLARA A. T. BOGGS

SECTION 4, T28S, R12W, W. M.

APPLICATION 70059

PERMIT 50771


RECEIVED

SEP 28 1993

WATER RESOURCES DEPT.
SALEM, OREGON



1 INCH = 1320 FEET

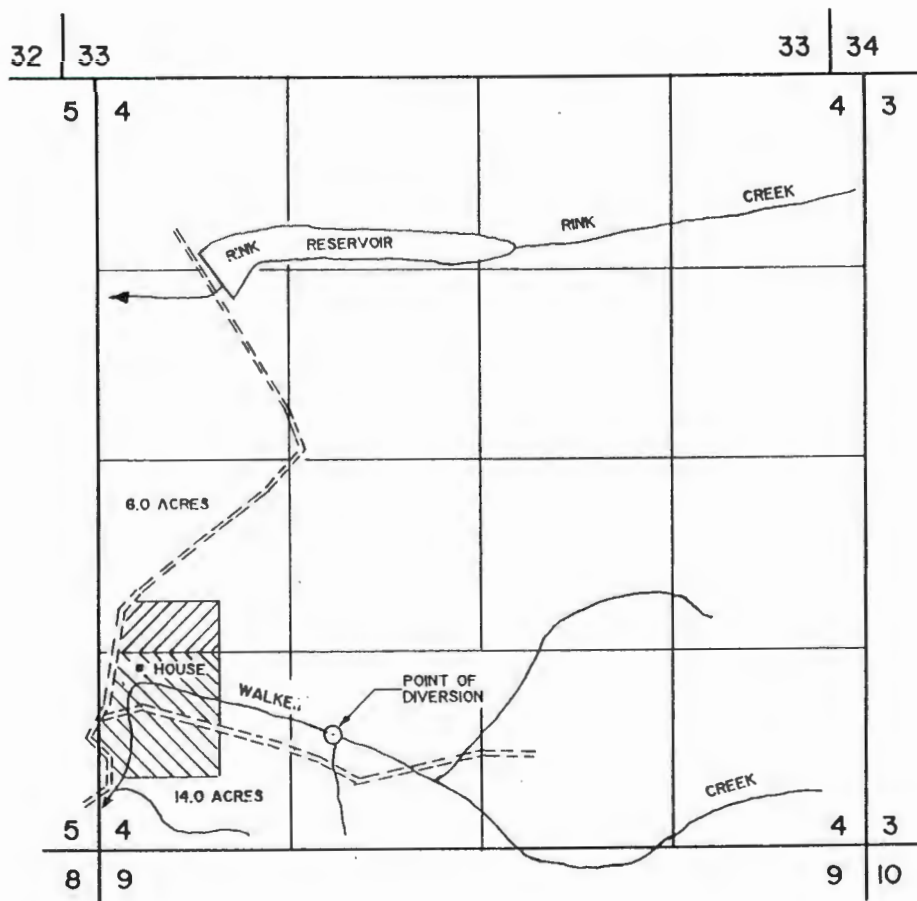

THE PURPOSE OF THIS MAP IS TO IDENTIFY THE LOCATION OF THE WATER RIGHT. IT IS NOT INTENDED TO PROVIDE INFORMATION RELATIVE TO THE LOCATION OF PROPERTY OWNERSHIP BOUNDARY LINES.

THE POINT OF DIVERSION IS TO BE LOCATED 780 FEET NORTH AND 1600 FEET EAST FROM THE SOUTHWEST CORNER OF SECTION 4, BEING WITHIN THE SE 1/4 OF THE SW 1/4 OF SECTION 4, TOWNSHIP 28 SOUTH, RANGE 12 WEST, W.M.

