

# Claim of Beneficial Use - Point of Appropriation Map

Permit G-15056 (Application G-15295)

Township 18 South, Range 12 West (W.M.)

File Path: \\gsi-sbs-001\Projects\180 - City of Florence\001 - Near-Term Water Supply\Project\_GIS\Project\_rxd\COBU\_POA\_Map.mxd



## Legend

- Point of Appropriation (POA)
- Florence City Limits
- Highways
- Roads
- Streams and Creeks
- Lakes and Rivers

## POA Legal Descriptions

### Point of Appropriation - Well 8

Located 2930 feet South and 1455 feet West from the NE corner of Section 23, Township 18 South, Range 12 West (W.M.)

### Point of Appropriation - Well 9

Located 1920 feet South and 1450 feet West from the NE corner of Section 23, Township 18 South, Range 12 West (W.M.)

### Point of Appropriation - Well 10

Located 1515 feet South and 1455 feet West from the NE corner of Section 23, Township 18 South, Range 12 West (W.M.)

### Point of Appropriation - Well 11

Located 905 feet South and 1425 feet West from the NE corner of Section 23, Township 18 South, Range 12 West (W.M.)

### Point of Appropriation - Well 12

Located 300 feet South and 1425 feet West from the NE corner of Section 23, Township 18 South, Range 12 West (W.M.)

\* Totalizing flow meter located at the wellhead of each POA

## Map Information

Projection: Oregon State Plane South Zone  
 Datum: North American Datum of 1983  
 Date: November 13, 2007  
 Prepared By: GSI Water Solutions, Inc.

## Data Sources

City of Florence, Oregon Geospatial Data Clearinghouse

## Note

This map was prepared for the purpose of identifying the location of a water right only and it is not intended to provide legal dimensions or location of property ownership lines.



## Scale

0 330 660 1,320

1 inch equals 1320 feet



EXPIRES: 12-31-2008

NAME stamp and signature

RECEIVED

JUN 24 2008

WATER RESOURCES DEPT  
 SALEM, OREGON




# Claim of Beneficial Use - Place of Use Map

Permit G-15056 (Application G-15295)

Township 18 South, Range 12 West (W.M.)

File Path: \\gsi-sbs-001\Projects\180 - City of Florence\001 - Near-Term Water Supply\Project\_GIS\Project\_mxd\COBU\_POU\_Map.mxd

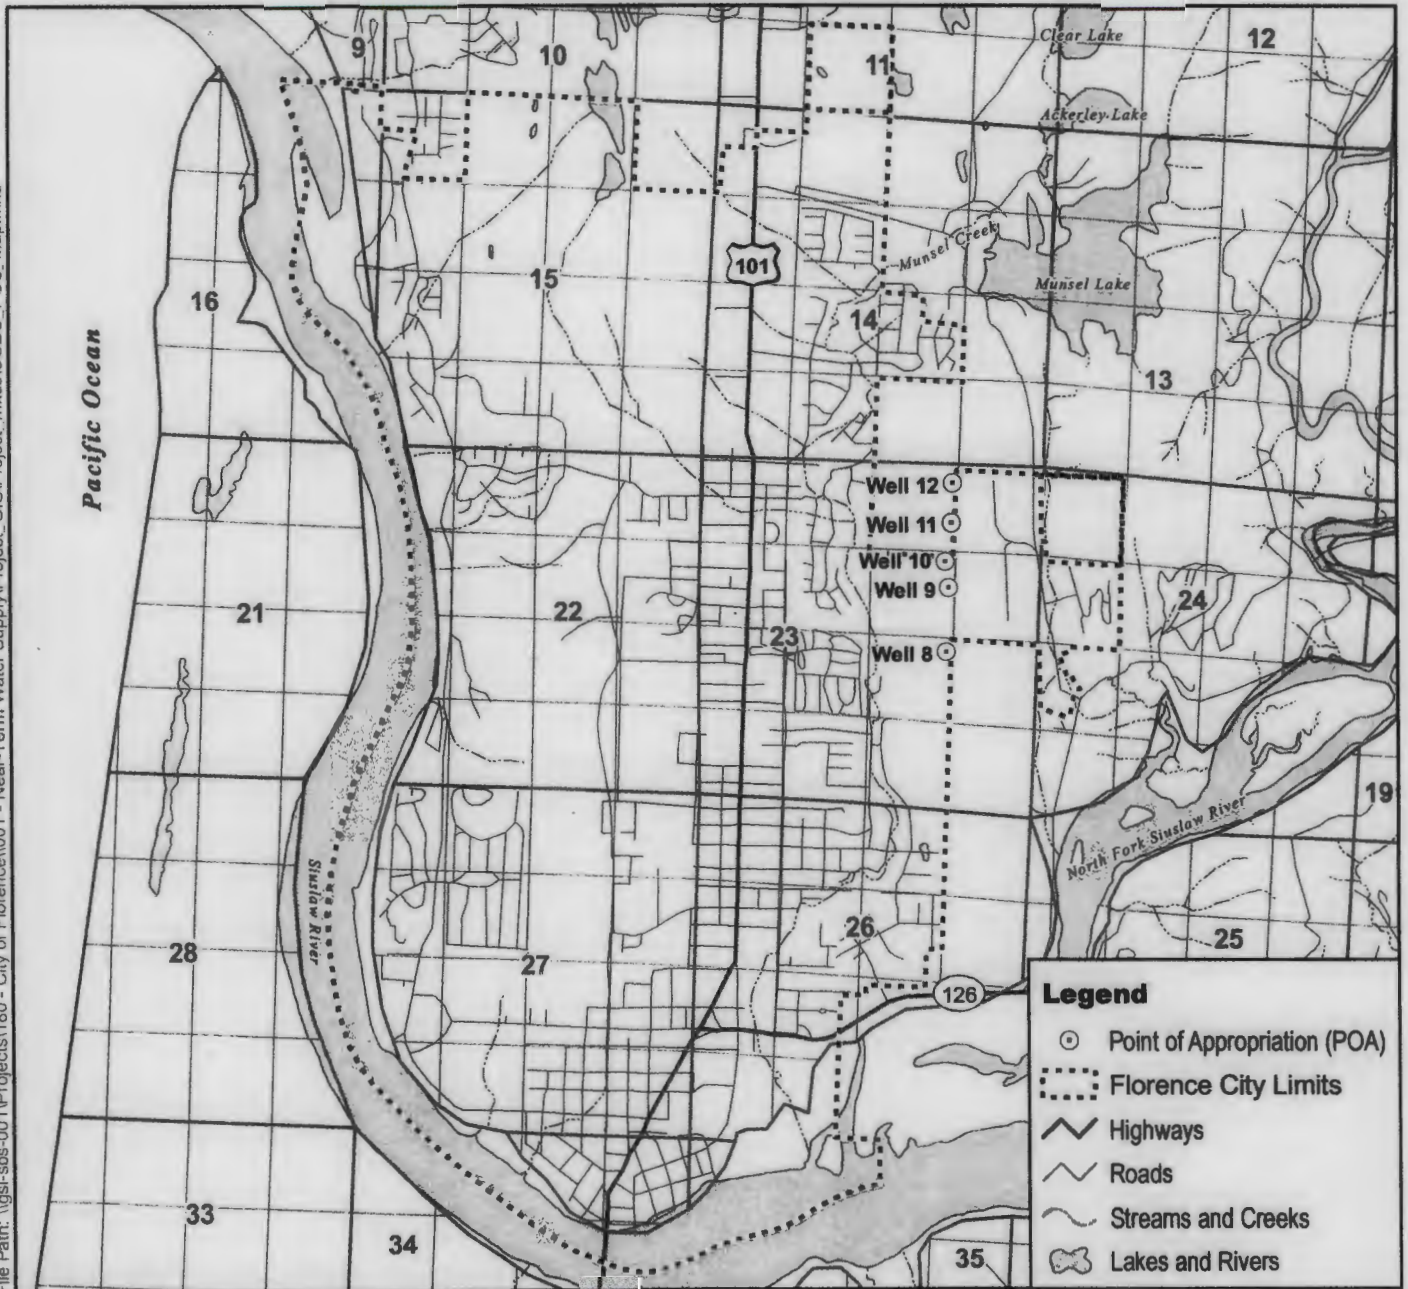

### Legend

- Point of Appropriation (POA)
- Florence City Limits
- == Highways
- Roads
- ~ Streams and Creeks
- ☪ Lakes and Rivers

### POU Description

The Place of Use is located within the service area boundary of City of Florence

### Map Information


Projection: Oregon State Plane South Zone  
 Datum: North American Datum of 1983  
 Date: November 13, 2007  
 Prepared By: GSI Water Solutions, Inc.

### Data Sources

City of Florence, Oregon Geospatial Data Clearinghouse

### Note

This map was prepared for the purpose of identifying the location of a water right only and it is not intended to provide legal dimensions or location of property ownership lines.

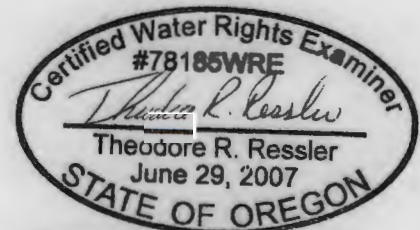

EXPIRES: 12-31-2008

CWRE stamp and signature

RECEIVED

JUN 24 2008

WATER RESOURCES DEPT  
 SALEM, OREGON



### Scale

0 750 1,500 3,000

1 inch equals 3000 feet

