


TOWNSHIP 19 SOUTH, RANGES 24 & 25 EAST, W.M.

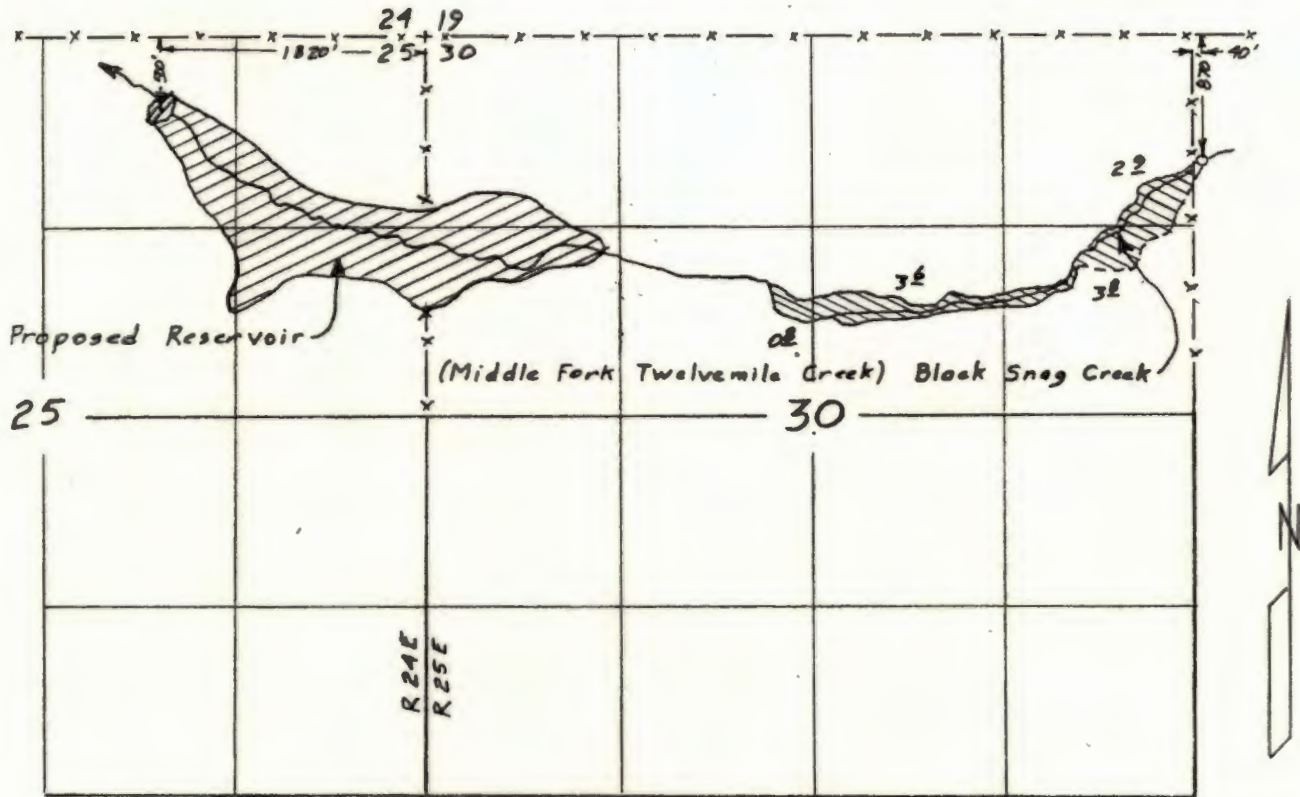


Surveyed March 13, 2000

Scale 1" = 1320'

- ⊗ Black Snag Reservoir
- ⊗ C-75727

T-7158

Claim of Beneficial Use Map  
for  
GI RANCH CORPORATION

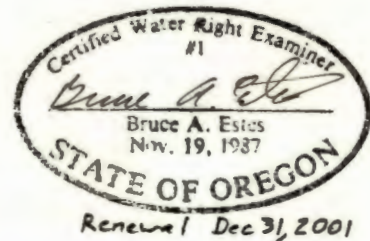

This map is for the purpose of locating a water right only and has no intent to provide legal dimensions or the location of property lines.

**ESTES SURVEYS**  
 PO Box 17519      60382 Arnold Rd  
 Salem, OR 97305-7519      Bend, OR 97702  
 (503) 585-7593      (541) 382-7391