


RECEIVED

JUN 14 2000

WATER RESOURCES DEPT.
SALEM, OREGON

T.7N., R.10W., W.M.
SECTIONS 9 AND 10

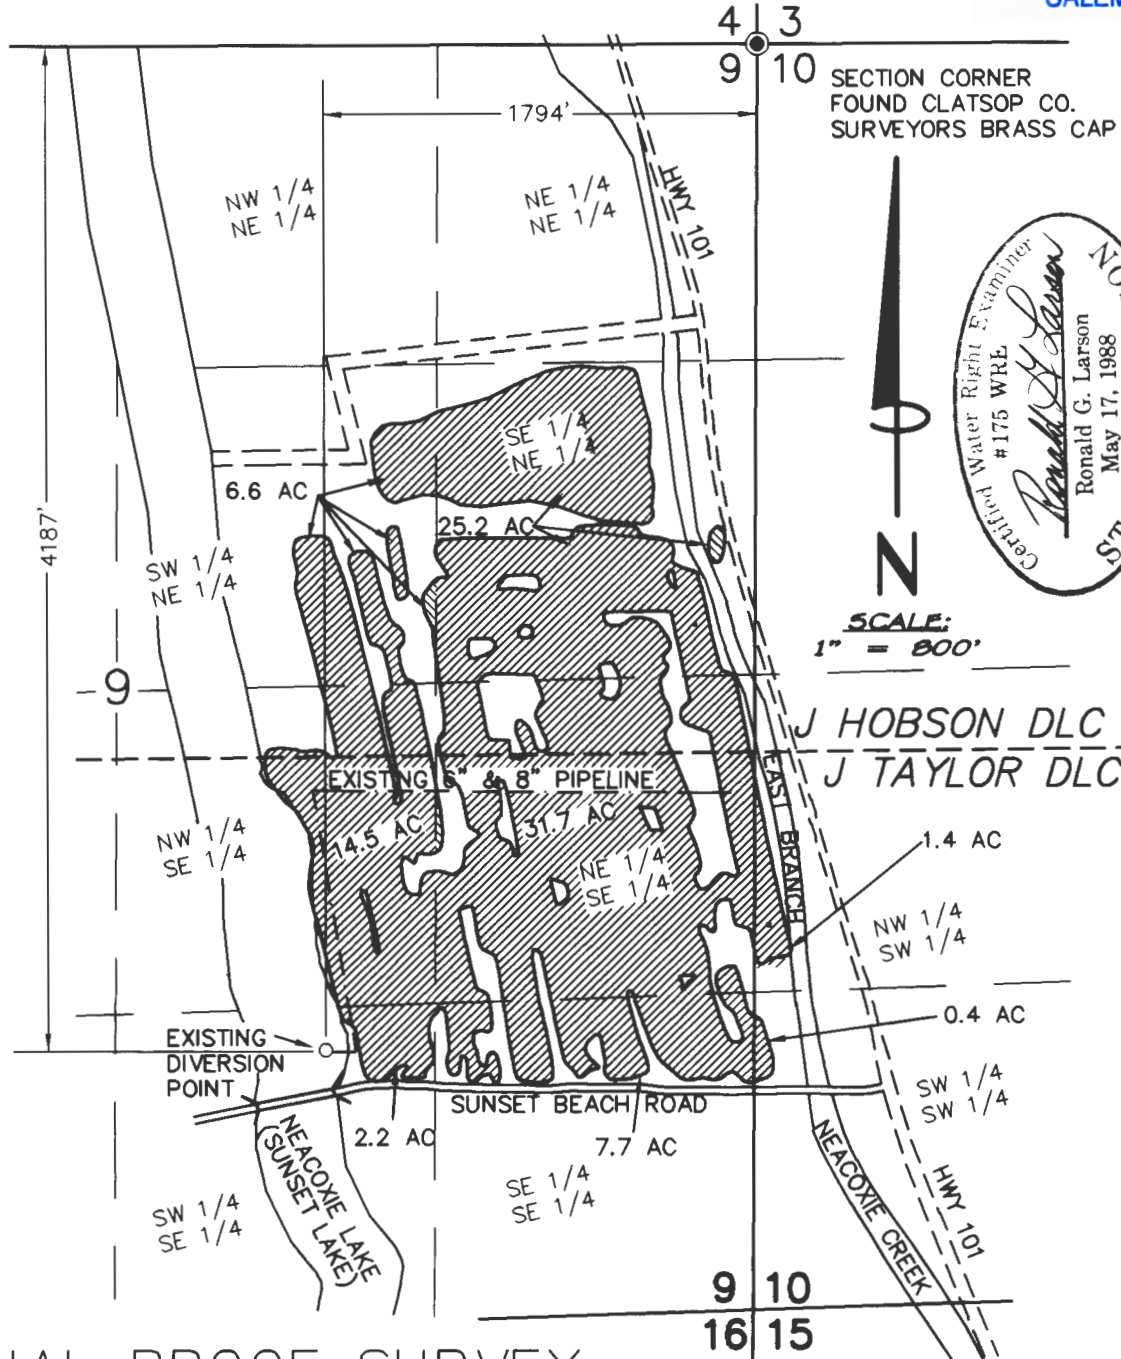

J HOBSON DLC #44
J TAYLOR DLC #43

FINAL PROOF SURVEY

UNDER
APPLICATION NO. T-8214,
CERTIFICATE NO. 27770
IN THE NAME OF
ASTORIA GOLF AND COUNTRY CLUB
SURVEYED FEB. 29, 2000

FILE: 2176-6916-01-06.DWG

HLB & ASSOCIATES, INC.
SURVEYING • ENGINEERING • PLANNING

160 LANEDA AVE.
MANZANITA, OR 97130
(503) 368-5394
FAX: (503) 368-5847

4253A HWY 101 N.
GEARHART, OR 97138
(503) 738-3425
FAX: (503) 738-7455