


CLAIM OF BENEFICIAL USE: PLACE OF USE MAP
TRANSFER T-7070 (PERMIT S-25114)
TOWNSHIP 10S, RIOW, W.M. LINCOLN COUNTY OREGON

CERTIFIED WATER RIGHTS EXAMINER
#84850CWRE
BRIAN L. ALLEN
SEP. 9, 2019
STATE OF OREGON

EXPIRATION DATE: 12-31-21

IN THE NAME OF
CITY OF SILETZ OREGON
NOVEMBER 3, 2020

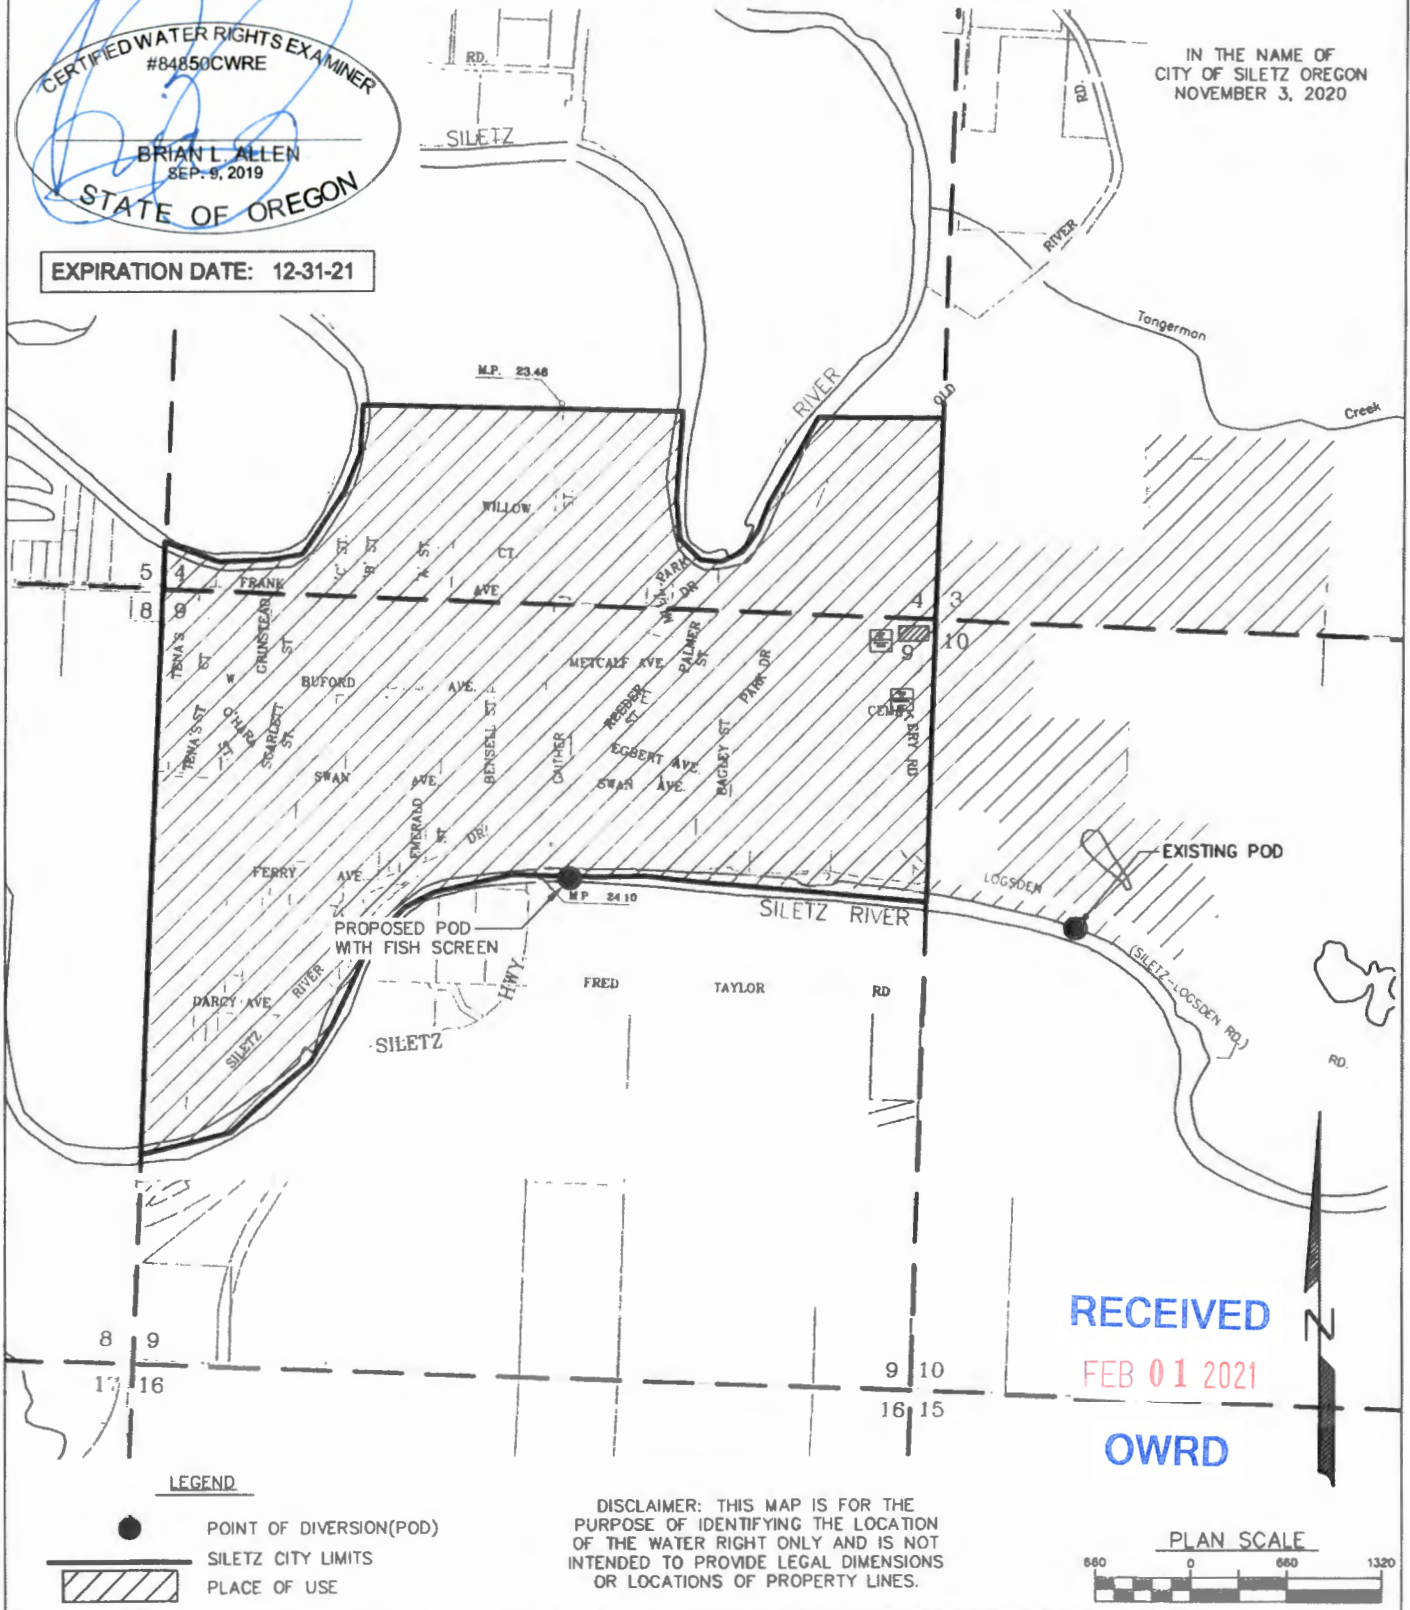

RECEIVED

FEB 01 2021

OWRD

THE DYER PARTNERSHIP
ENGINEERS & PLANNERS, INC.

DATE: NOV 2020

PROJECT NO.: 133.21

CITY OF SILETZ
WATER RIGHT CLAIM OF BENEFICIAL USE

PLACE OF USE MAP


FIGURE NO.

2

CERTIFIED WATER RIGHTS EXAMINER
#84650CWRE
BRIAN L. ALLEN
SEP. 9, 2019
STATE OF OREGON

EXPIRATION DATE: 12-31-21

EXPIRATION DATE: 12-31-21

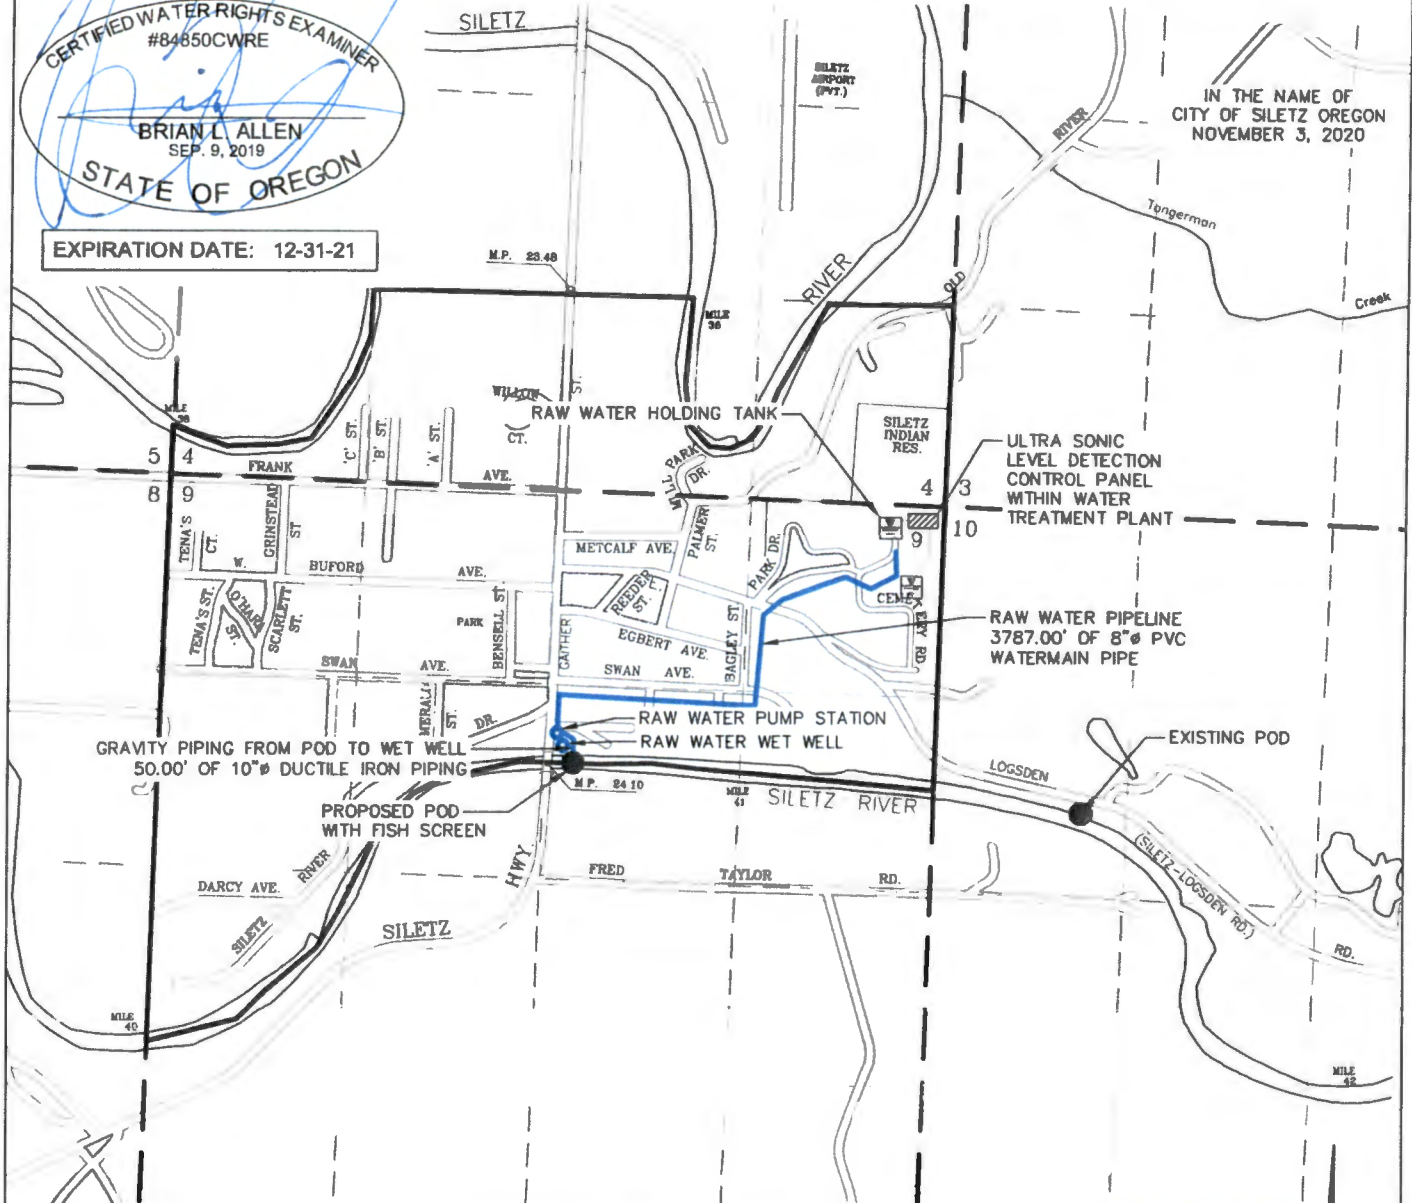

 POINT OF DIVERSION(POD)
 RAW WATER PIPELINE
 SILETZ CITY LIMITS
 SECTION LINES
 1/16 SECTION LINES

DISCLAIMER: THIS MAP IS FOR THE
PURPOSE OF IDENTIFYING THE LOCATION
OF THE WATER RIGHT ONLY AND IS NOT
INTENDED TO PROVIDE LEGAL
DIMENSIONS OR LOCATIONS OF
PROPERTY LINES.

EXISTING POD
700' SOUTH, 1000' EAST OF THE NW CORNER OF THE SW 1/16
CORNER OF THE NW 1/4 OF SECTION 10, TOWNSHIP 10 SOUTH,
RANGE 10 WEST (W.M.). LOCATION APPROXIMATE. EXISTING POD
HAS BEEN REMOVED.

SOUTH 54° 37' 04" EAST A DISTANCE OF 3288.52' FROM THE NORTHWEST CORNER OF SECTION 9, TOWNSHIP 10 SOUTH, RANGE 10 WEST (W.M.).

SOUTH 86° 47' 22" EAST, A DISTANCE OF 5169.23' FROM THE NORTHWEST CORNER OF SECTION 9, TOWNSHIP 10 SOUTH, RANGE 10 WEST (W.M.).

SOUTH 84° 46' 57" EAST, A DISTANCE OF 4960.66' FROM THE NORTHWEST CORNER OF SECTION 9, TOWNSHIP 10 SOUTH, RANGE 10 WEST (W.M.)

OWRD



PROJECT NO.: 133.21

POINT OF DIVERSION TRANSFER

FIGURE NO. _____

1