


# ACMPC Oregon 3, LLC T-12835 Claim of Beneficial Use

0 660 1,320 2,640 Feet

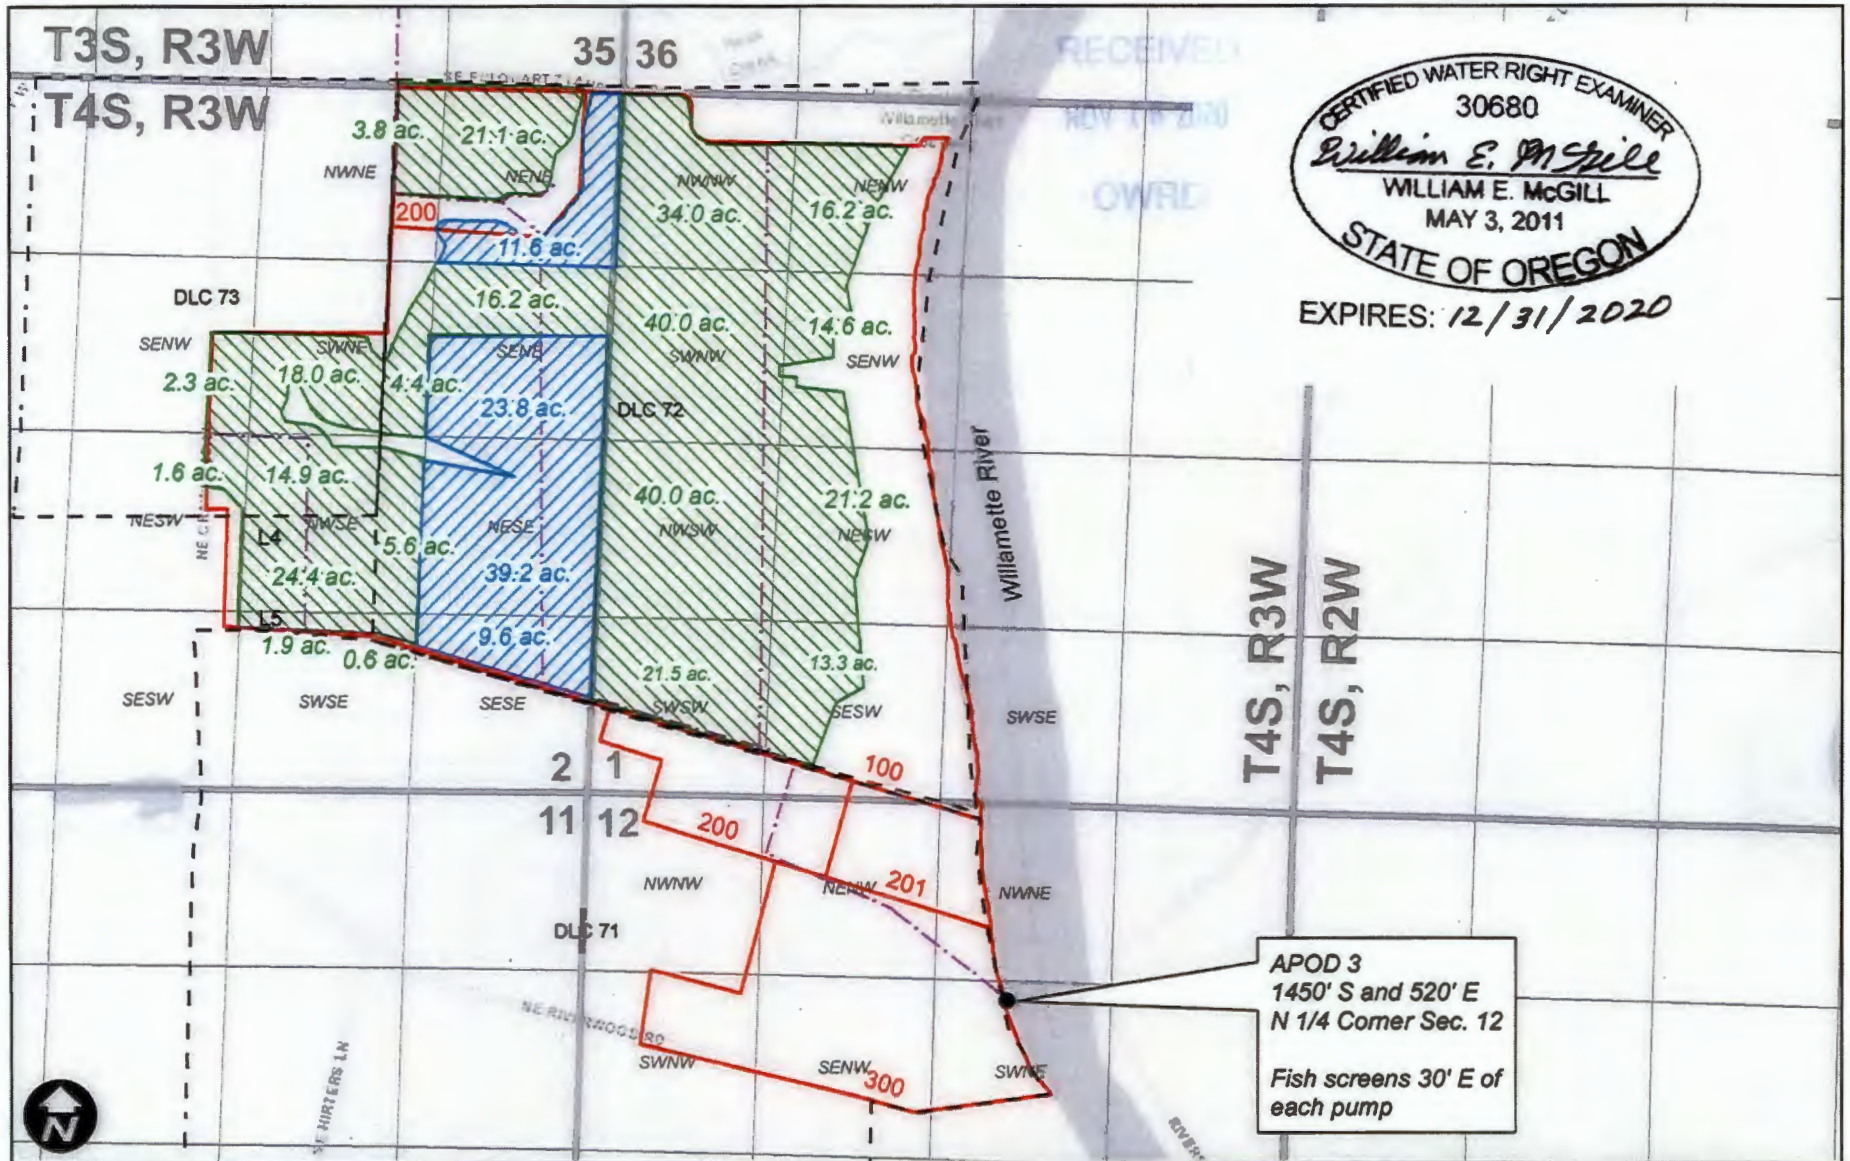

## Legend

Cert. 64644
  Cert. 64645
  Mainline
  Taxlot
  DLC

This map is not intended to provide legal dimensions or locations of property ownership lines.



WILL MCGILL  
SURVEYING LLC

15333 Pletzer Rd. SE  
Turner, OR 97392  
503-510-3026  
willmcgillsurveying@gmail.com