



Claim of Beneficial Use - Etzel Transfer T-13120

Township 9S, Range 1W, W.M.

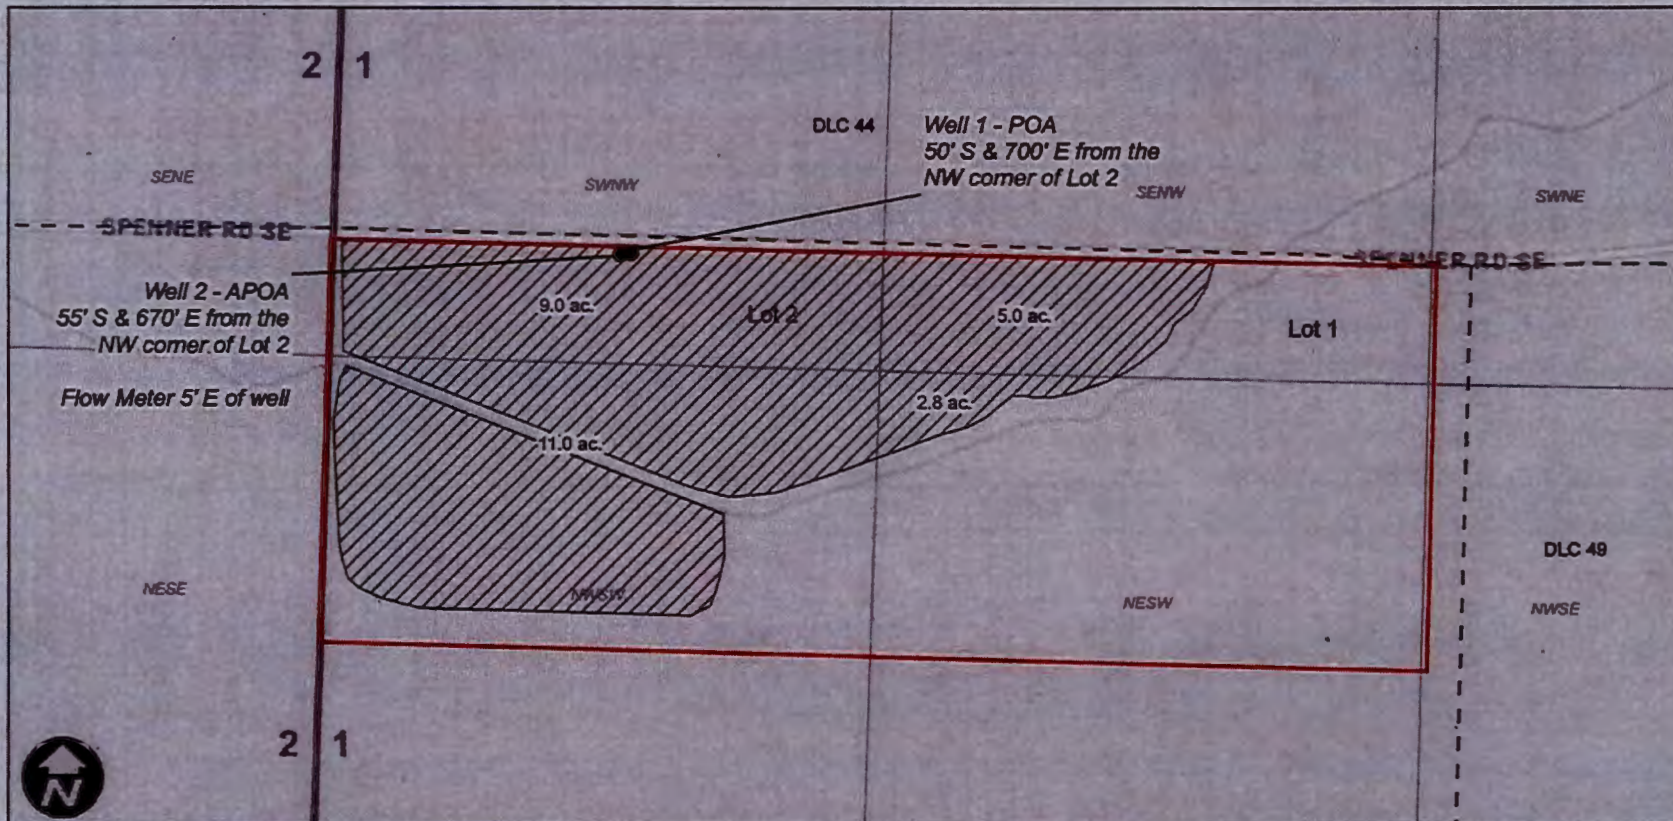


This map is not intended to provide legal dimensions or locations of property ownership lines.

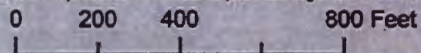

Legend

- T-13120 POU
- Taxlot 400
- DLC

WILL MCGILL SURVEYING LLC

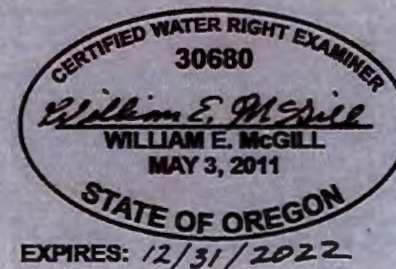

RECEIVED
SEP 13 2021
OWRD