


ACMPC Oregon 3, LLC T-12306 Claim of Beneficial Use

Township 4S, Range 3W



EXPIRES: 12/31/2020

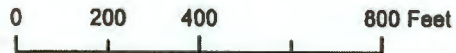


Legend

- POU
- Tax Lot
- DLC

This map is not intended to provide legal dimensions or locations of property ownership lines.

WILL MCGILL SURVEYING LLC
15333 Pletzer Rd. SE | 503-510-3026
Turner, OR 97392 | willmcgillsurveying@gmail.com

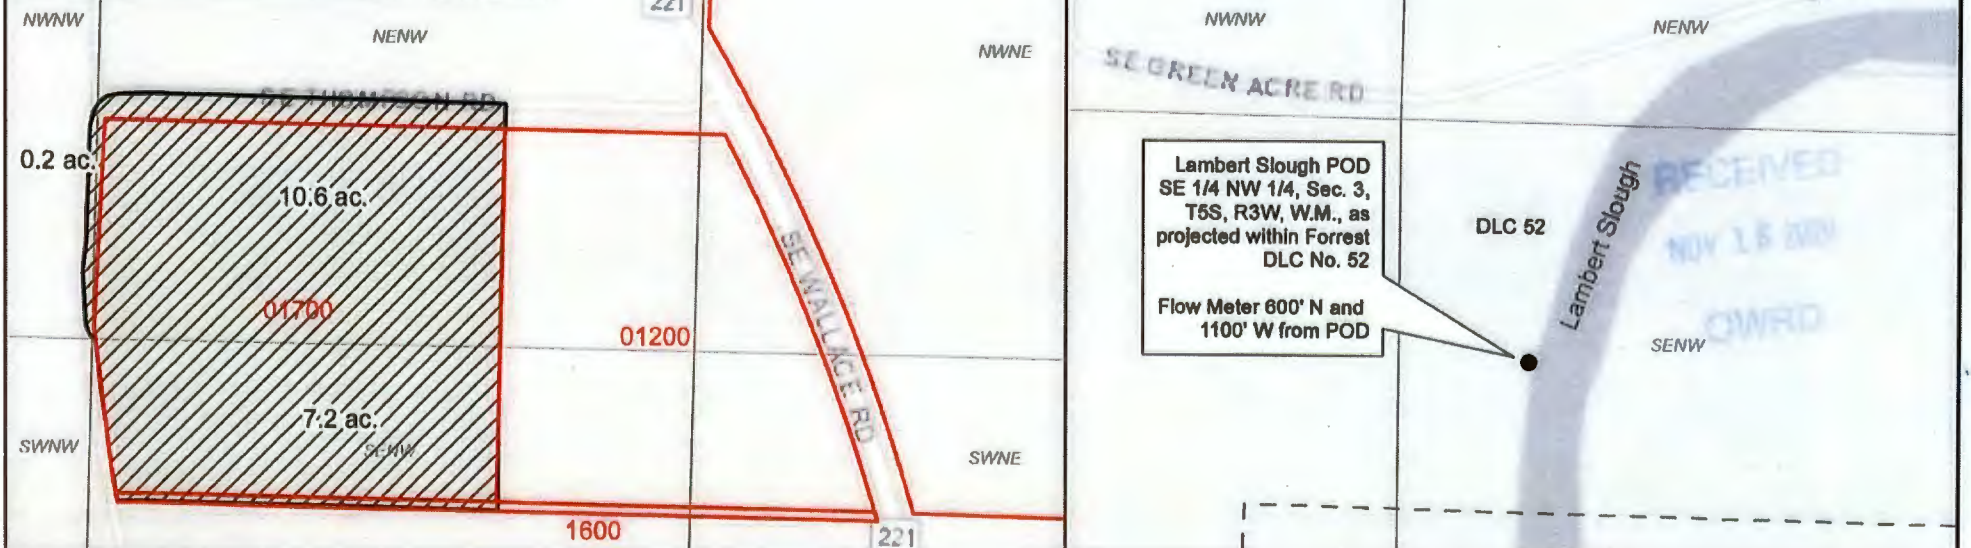

APOD 1
950' N and 1980' W from the
SE corner of section 16

Fish screen at APOD 1, flow
meter 150' S of APOD 1.

Lambert Slough POD
SE 1/4 NW 1/4, Sec. 3,
T5S, R3W, W.M., as
projected within Forrest
DLC No. 52

Flow Meter 600' N and
1100' W from POD

