
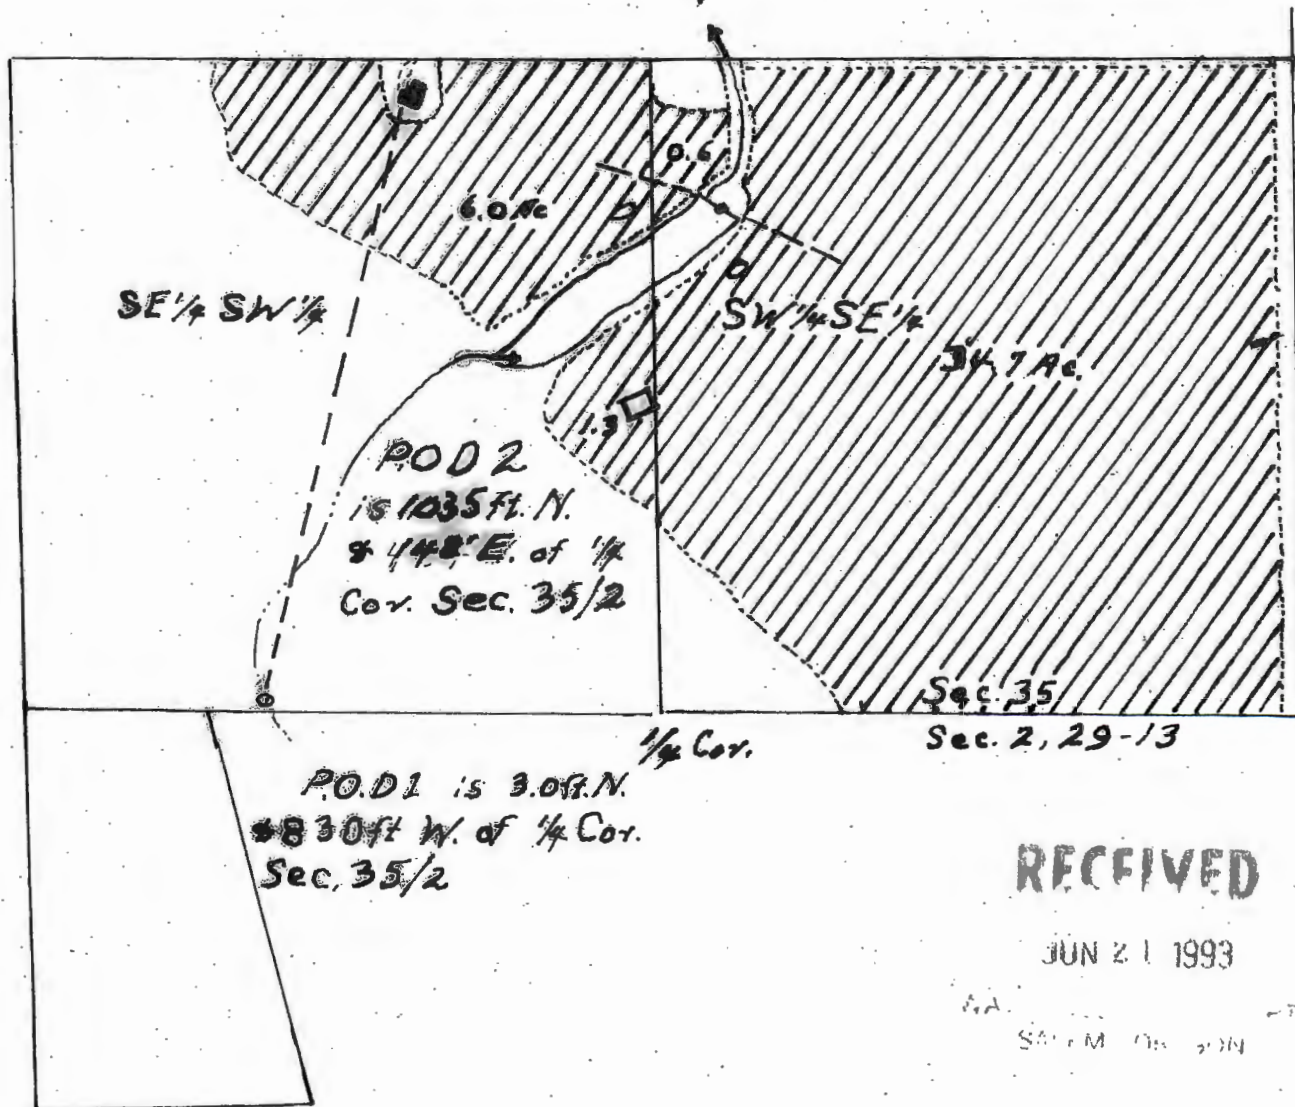


T. 28 S., R. 13 W. Sec. 35
FINAL PROOF SURVEY
UNDER

Application No. 70271, R 70271, Permit No. 51193 + R 11355.
Scale: 1" = 400 ft Surveyed May 24, 1993.

For: Jordan Utsey (Western Research and Development Co.)
This map is not the result of a property survey
and is not to be used as such.

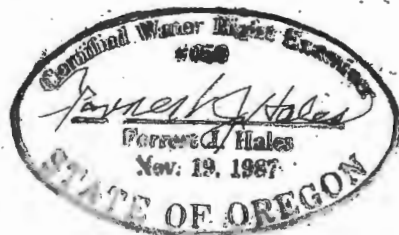

RECEIVED

JUN 21 1993

SALEM, OREGON