

FINAL PROOF SURVEY MAP

IN THE NAME OF TOM R. BOWERMAN

SECTION 29, TOWNSHIP 23 SOUTH, RANGE 4 WEST, W.M.

APPLICATION R-70344

PERMIT R-11256

APPLICATION 70345


PERMIT 51103

AUG 12 1987

WATER
SALEM, OREGON



1 INCH = 1320 FEET

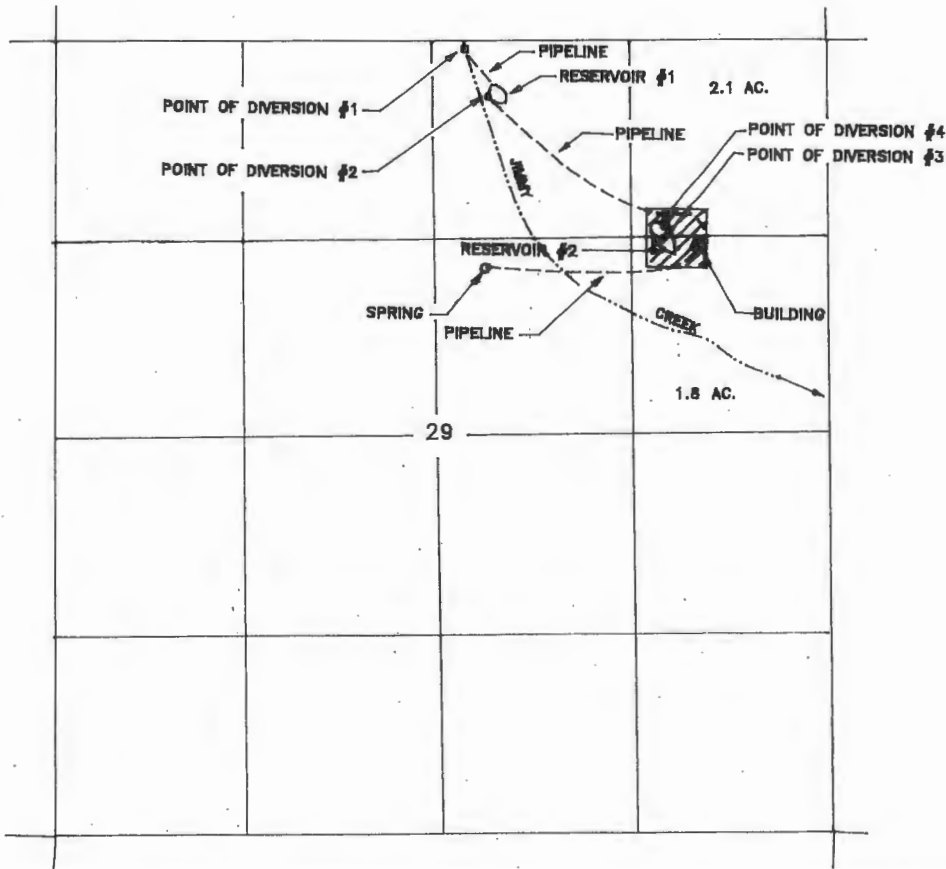

29

P.O.D.			POINT OF CALL	LOCATION
#1	40' SOUTH	2440' WEST	NE COR. S29	NW1/4 NE1/4 S29
#2	360' SOUTH	2280' WEST	NE COR. S29	NW1/4 NE1/4 S29
#3	1350' SOUTH	1170' WEST	NE COR. S29	SE1/4 NE1/4 S29
#4	1230' SOUTH	1100' WEST	NE COR. S29	NE1/4 NE1/4 S29
SPRING	1520' SOUTH	2310' WEST	NE COR. S29	SW1/4 NE1/4 S29

THE PURPOSE OF THIS MAP IS TO IDENTIFY THE LOCATION OF THE WATER RIGHT. IT IS NOT INTENDED TO PROVIDE INFORMATION RELATIVE TO THE LOCATION OF PROPERTY OWNERSHIP BOUNDARY LINES.

