


COBU MAP # 1231 (A)

LEGEND	
DISCRIPTION	SYMBOLS
SECTION LINE	—————
QUARTER-QUARTER LINE ROAD	- - - - -
TAX LOT LINE	=====
DIRT DITCH	=====
DRAIN DITCH	- - - - -
BURIED MAIN LINE	-----
SECTION CORNER	15   14 22   23
RECOGNIZED SURVEY CORNER	⊕
POINT OF DIVERSION	Ⓟ
PLACE OF USE	 47.66 ACRES

RECEIVED  
MAY 20 2020  
OWRD

POINTS OF DIVERSION  
 POD No. 1: NE 1/4 NW 1/4, SECTION 32, T.15 S., R.47 E., W.M.; 10' SOUTH & 1325' EAST FROM THE NW SECTION CORNER.  
 POD No. 2: NW 1/4 NW 1/4, SECTION 32, T.15 S., R.47 E., W.M.; 580' SOUTH & 590' EAST FROM THE NW SECTION CORNER.

APPLICATION No.: S-88211  
 PERMIT No.: S-55106


RECEIVED  
APR 30 2020  
OWRD



RENEWS: 6/30/2020

**DISCLAIMER**

THIS MAP WAS MADE TO ACCOMPANY THE APPLICATION FOR A CLAIM OF BENEFICIAL USE. SECTIONAL LINES SHOWN ARE APPROXIMATE AND THIS MAP IS NOT INTENDED FOR ANY OTHER USE AND DOES NOT GUARANTEE LAND OWNERSHIP.

  
 IF THIS BAR SCALE  
 DOES NOT MEASURE 1"  
 THEN THIS DRAWING IS  
 NOT TO SCALE


Reviewed By: PAT J. WOODCOCK  
 Drawn By: PJW  
 Print Date: APRIL 20, 2020  
 DWG. Scale: AS SHOWN


CLAIM OF BENEFICIAL USE MAP  
 within Sections 29 & 32  
 T.15 S., R. 47 E., W.M.  
 MALHEUR COUNTY, OREGON  
 VAL GRIFFITH  
 5484 BUCKHORN ROAD  
 ONTARIO, OREGON 97914

ENGINEERING  
 NORTHWEST, LLC  
 372 SW 1st Avenue  
 P.O. BOX 308  
 Ontario, Oregon 9794  
 (541) 889-4432 • (541) 709-0905




**W1**  
 SHEET NO. 1 OF 2  
 JOB NO. 18-085

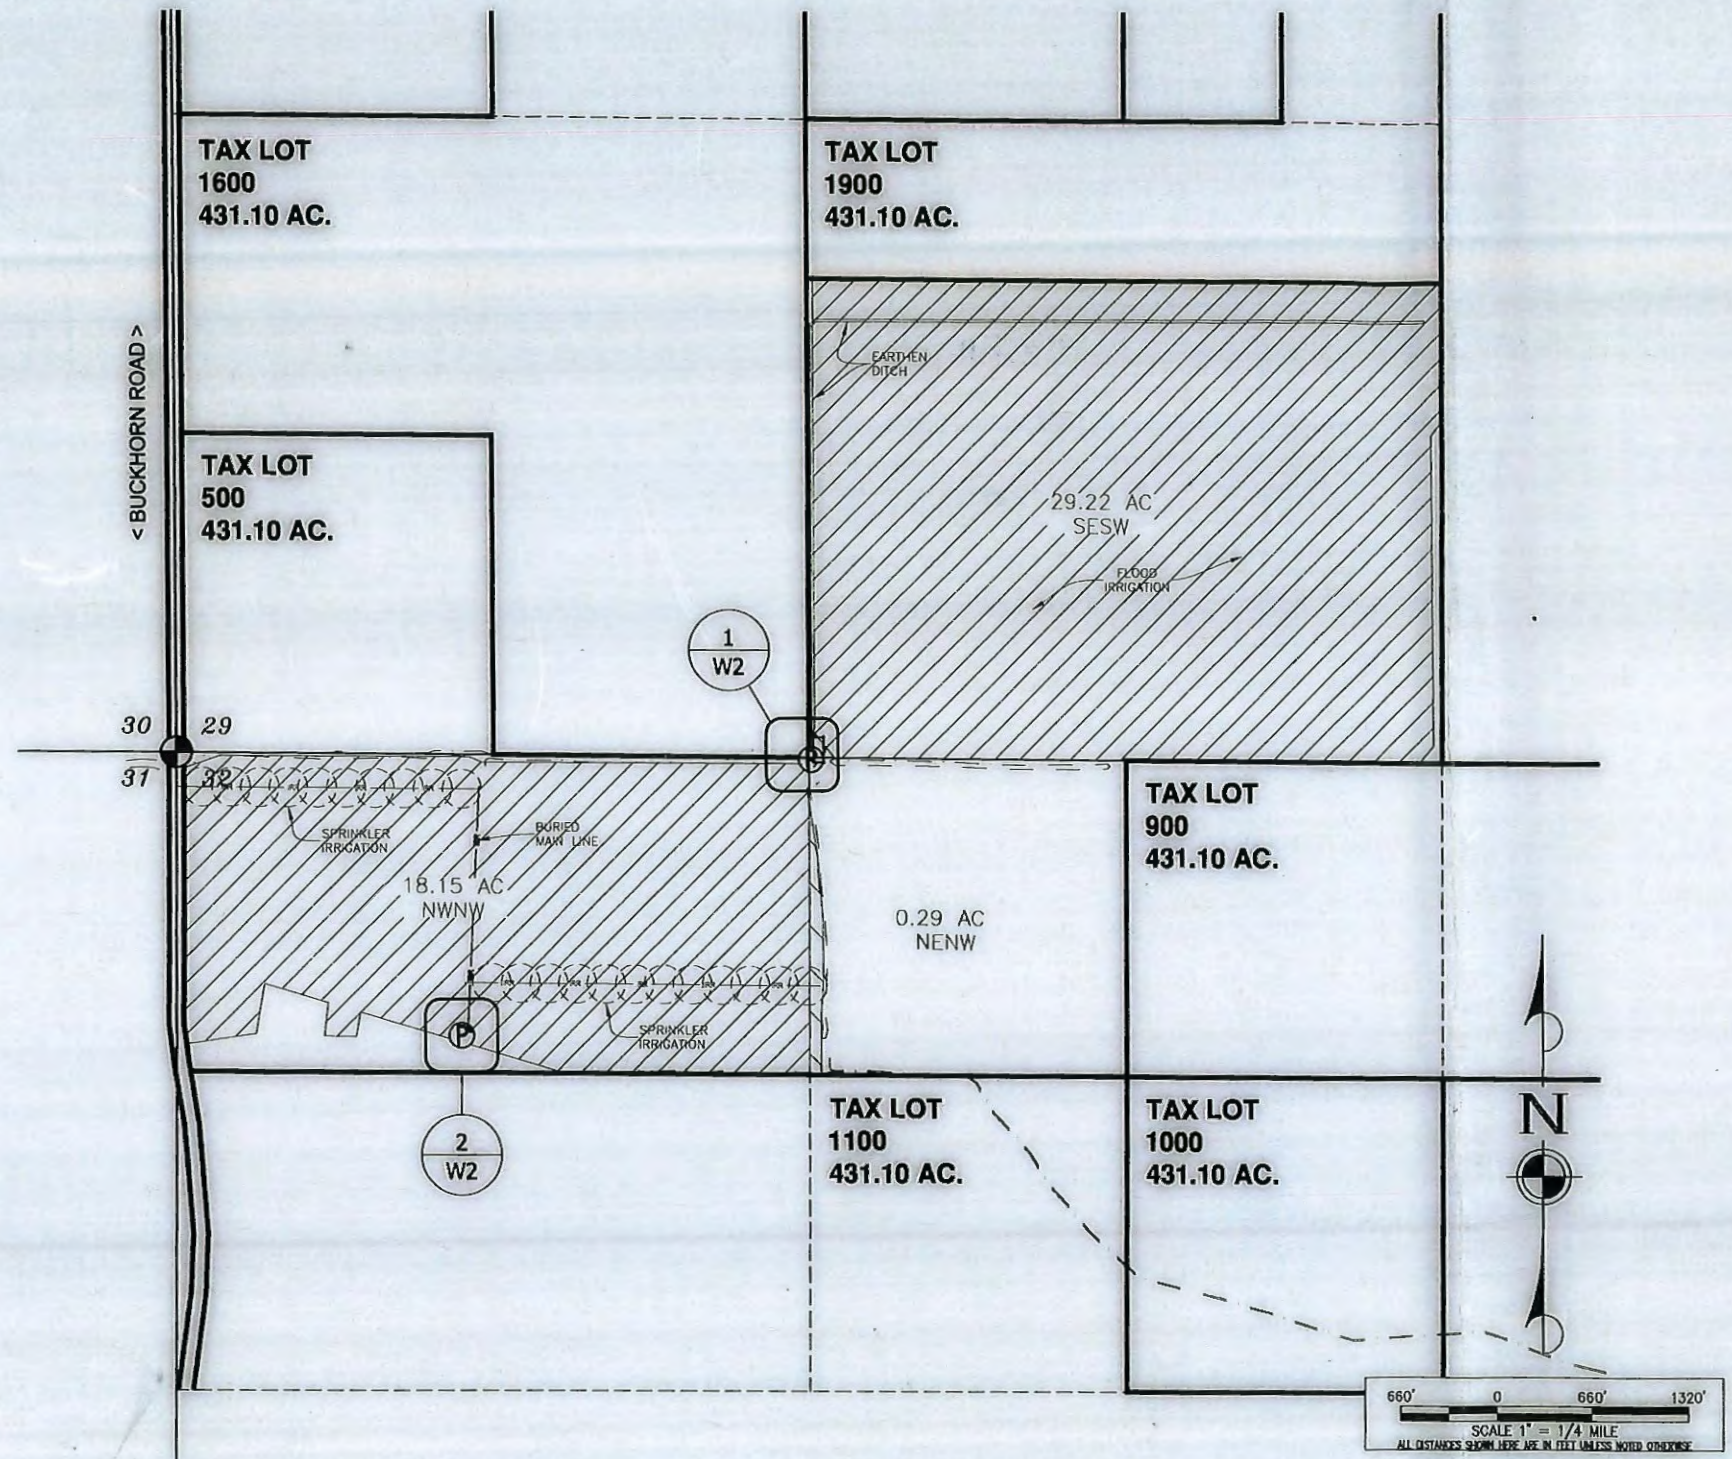

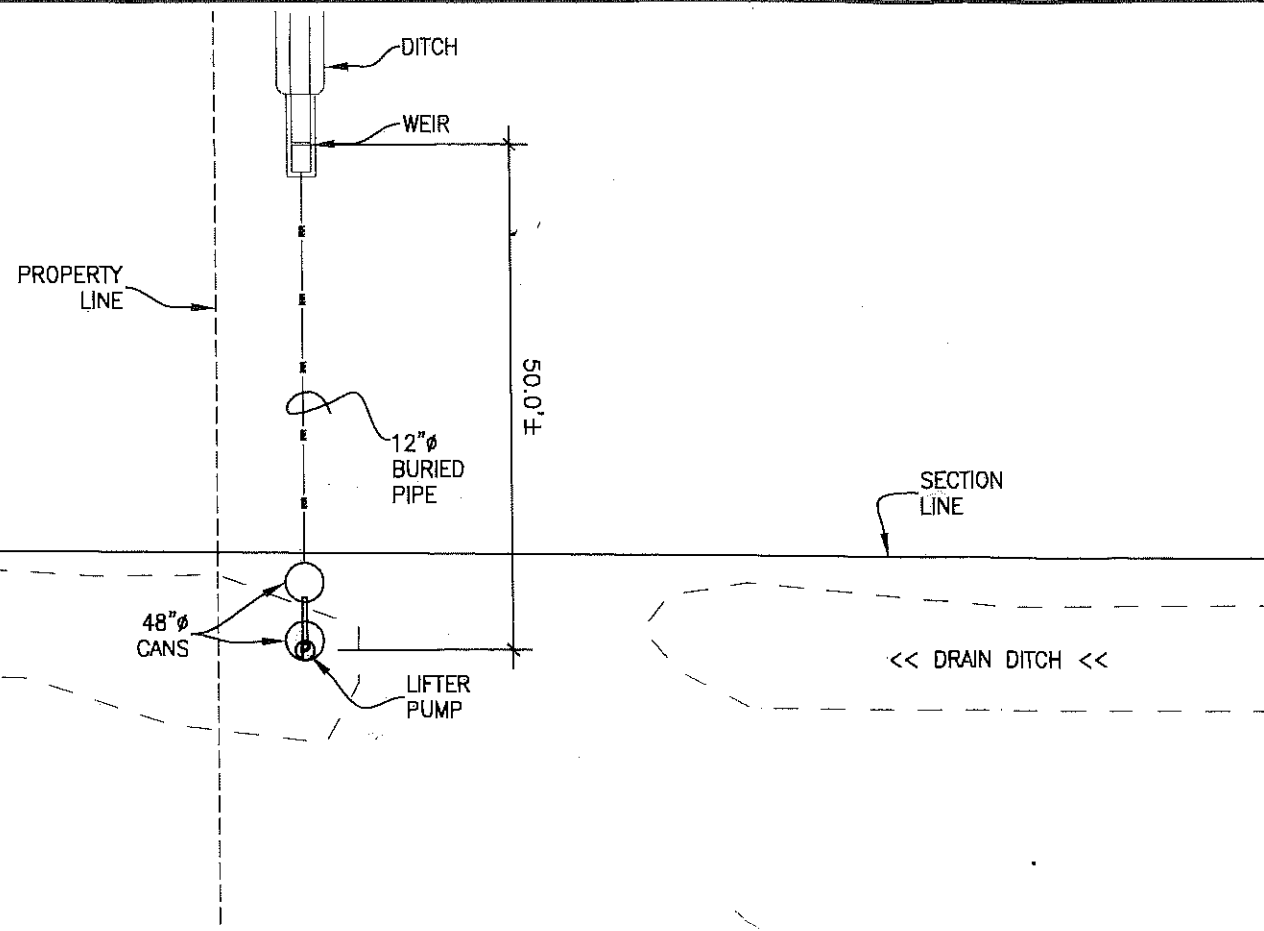

1 POINT OF DIVERSION #1 ENLARGED DETAIL

SCALE 1:20

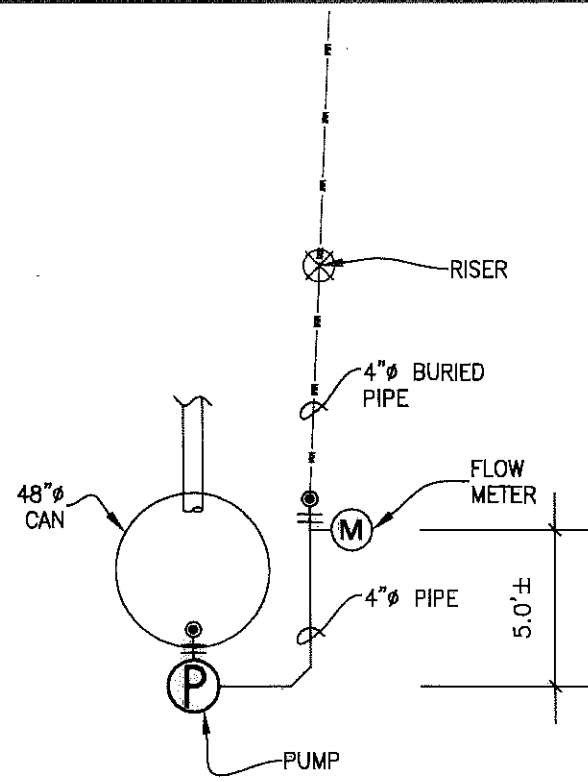

2 POINT OF DIVERSION #2 ENLARGED DETAIL


SCALE 1:5

LEGEND	
DISCRIPTION	SYMBOLS
SECTION LINE	— — — — —
QUARTER-QUARTER LINE ROAD	- - - - -
TAX LOT LINE	=====
DIRT DITCH	=====
DRAIN DITCH	- - - - -
BURIED MAIN LINE	— — — — —
PUMP	⊕

RECEIVED  
MAY 20 2020  
OWRD

RECEIVED  
APR 30 2020  
OWRD

APPLICATION No.: S-88211  
PERMIT No.: S-55106

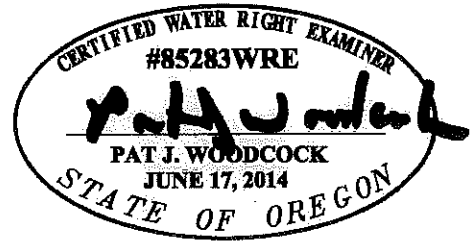

RENEWS: 6/30/2020

**DISCLAIMER**


THIS MAP WAS MADE TO ACCOMPANY THE APPLICATION FOR A CLAIM OF BENEFICIAL USE. SECTIONAL LINES SHOWN ARE APPROXIMATE AND THIS MAP IS NOT INTENDED FOR ANY OTHER USE AND DOES NOT GUARANTEE LAND OWNERSHIP.

IF THIS BAR SCALE DOES NOT MEASURE 1" THEN THIS DRAWING IS NOT TO SCALE

Reviewed By: PAT J. WOODCOCK  
Drawn By: PJW  
Print Date: APRIL 20, 2020  
DWG. Scale: AS SHOWN

**CLAIM OF BENEFICIAL USE MAP**  
within Sections 29 & 32  
T.15 S., R. 47 E., W.M.  
MALHEUR COUNTY, OREGON  
**VAL GRIFFITH**  
5484 BUCKHORN ROAD  
ONTARIO, OREGON 97914

**ENGINEERING NORTHWEST, LLC**  
372 SW 1st Avenue  
P.O. BOX 308  
Ontario, Oregon 97914  
(541) 889-4434 • (541) 709-0905

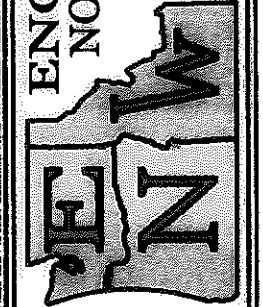

**W2**  
SHEET NO. 2 OF 2  
JOB NO. 18-085