


T. 4 S., R. 4 W., W.M.

Location: The NE 1/4 & NW 1/4 & SE 1/4 & SW 1/4 of the SE 1/4 and the SW 1/4 & SE 1/4 of the NE 1/4, all within Section 3, Township 4 South, Range 4 West, Willamette Meridian, within the Charles S. Tustin DLC No. 45 and the Miles Cary DLC No. 44, Yamhill County, Oregon.

LEGEND:

- = Property line
- = D.L.C. line
- = Section line
- = "40" line

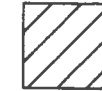

PLACE OF USE
= APP. G-16731 PER. G-16289
APP. S-86913 PER. S-54446

- = Well

Tax Lot: 4403-400

Date : 16 September 2013

Scale : 1" = 400'

By : MAGNESS LAND SURVEYING

PO BOX 1239

WILLAMINA, OREGON, 97396


Cell : 971-237-3413

E-Mail : MAGNESS@WBCABLE.NET

I certify that the information I have provided in this final proof is an accurate representation of the actual water use and is true and correct to the best of my knowledge. It is to be used for the purpose of identifying the location of water right only and is not intended to provide legal dimensions or locations of property ownership lines.

Nathan Magness

NATHAN MAGNESS, CWRE 60087

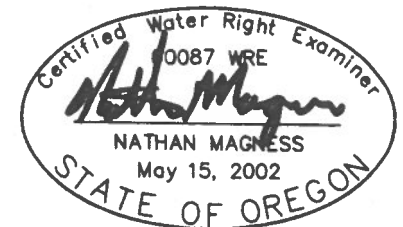

FINAL PROOF SURVEY

UNDER

Application No. G-16731	Permit No. G-16289
Application No. S-86913	Permit No. S-54446
Application No. R-86790	Permit No. R-14431

IN NAME OF

RANDAL AEBI

Surveyed September 16, 2013.

RECEIVED

SEP 30 2013

WATER RESOURCES DEF
STATE OF OREGON

WELL "A"
NORTH 1392 FT AND
WEST 1136 FT OF
THE ANGLE CORNER
OF THE TUSTIN DLC
45. POINT OF
DIVERSION FOR APP.
G-16731 PER.
G-16289.

WELL "C"
NORTH 2220 FT AND WEST 821
FT OF THE ANGLE CORNER OF
THE TUSTIN DLC 45. POINT OF
DIVERSION FOR
APP. G-16731 PER. G-16289.

POVERTY BEND ROAD

North

Scale: 1"=400'

SECTION 3

SECTION 10

3

2

10

11

COBU MAP # 789

POVERTY RESERVOIR
NORTH 21 FT AND EAST 121
FT OF THE ANGLE CORNER
OF THE TUSTIN DLC 45.
POINT OF DIVERSION FOR
APP. S-86913 PER.
S-54446 & APP. R-86790
PER. R-14431. PLACE OF
USE FOR APP. R-86790
PER. R-14431.

WELL "B"
NORTH 21 FT AND WEST
1 FT OF THE ANGLE
CORNER OF THE TUSTIN
DLC 45. POINT OF
DIVERSION FOR APP.
G-16731 PER. G-16289.

ANGLE CORNER
CHARLES
TUSTIN DLC
NO. 45. FOUND
BRASS CAP.

TAX LOT
4403-400

UNNAMED
STREAM

HAND PUMP
LINE SITE

BIG
GUN

21.7

14.3

13.3

8.5

9.5

6.5

0.6