







**Claim of Beneficial Use Map**  
**Application G-18102, Permit G-18464**  
**Dennis & Andrea Flynn**

T 35 S, R 21 E, WM  
 Section 31

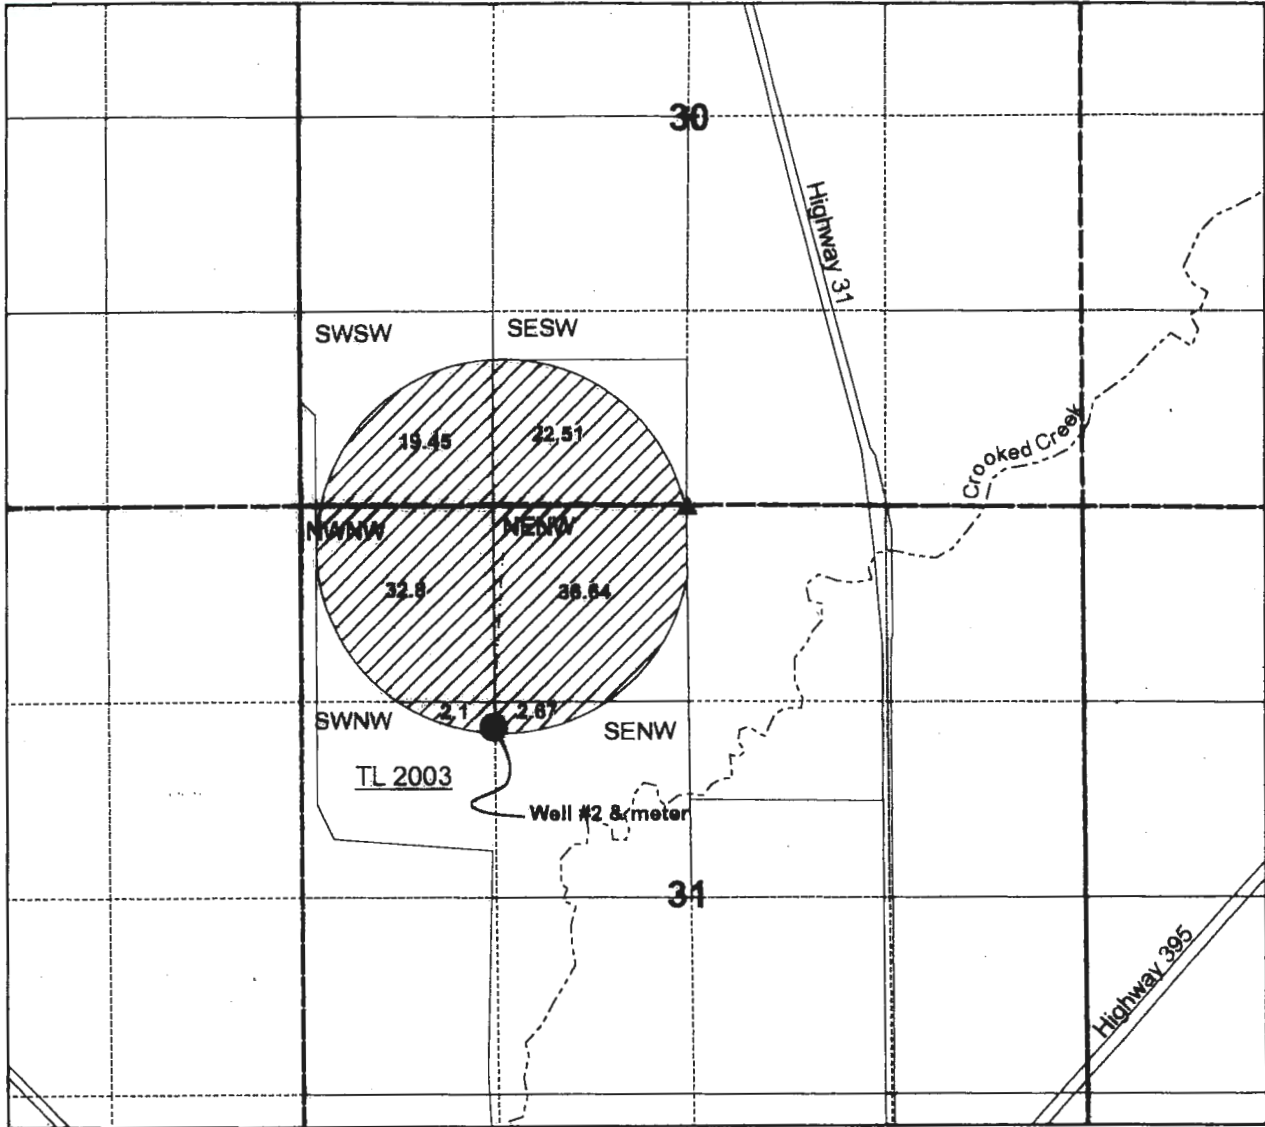

**Legend**

-  Area irrigated 116.17 ac
-  Well #2 Lake 52807 & meter
-  Pipeline
-  Reference Corner N 1/4 Cor. Sec 31
-  Crooked Creek



1 inch = 1,320 feet

Well #2 LAKE 52807  
 1506.6 ft South & 1320.9 ft West  
 Fm the North 1/4 Cor. Sec 31  
 T 35 S, R 21 E, WM  
 Located in the SWNW



**Note: This map is not intended to provide legal dimensions or locations of property ownership lines.**