


**Evans Ranch Land LLC**  
**Claim of Beneficial Use Map**  
**T-13502**  
**Certificate 53146, 87093 & 95027**

T 40 S, R 18 E, WM  
 Section 36

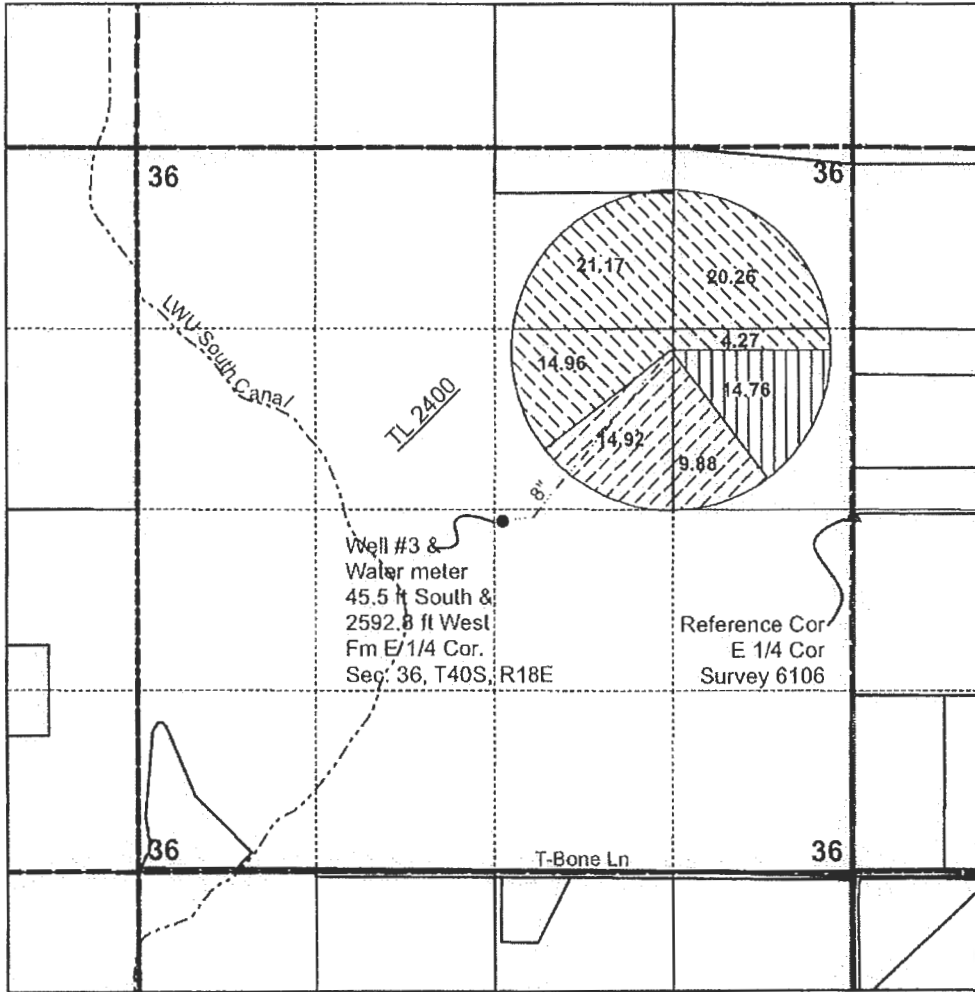


**Legend**

- T13502 C 53146 place of use 24.8 ac
- T-13502 C 87093 Place of use 60.66 ac
- T-13502 C 95027 place of use 14.76 ac
- Pipeline
- Well
- Ref Cor LCS 6106



1 inch = 1,320 feet

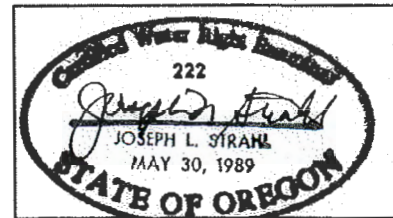

*Expires 06/30/2022*

Note: This map is not intended to provide legal dimensions or locations of property ownership lines.