
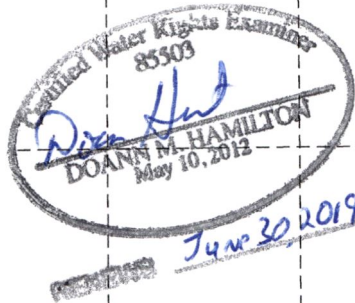


T.3S. R.1E. Section 8, W.M.

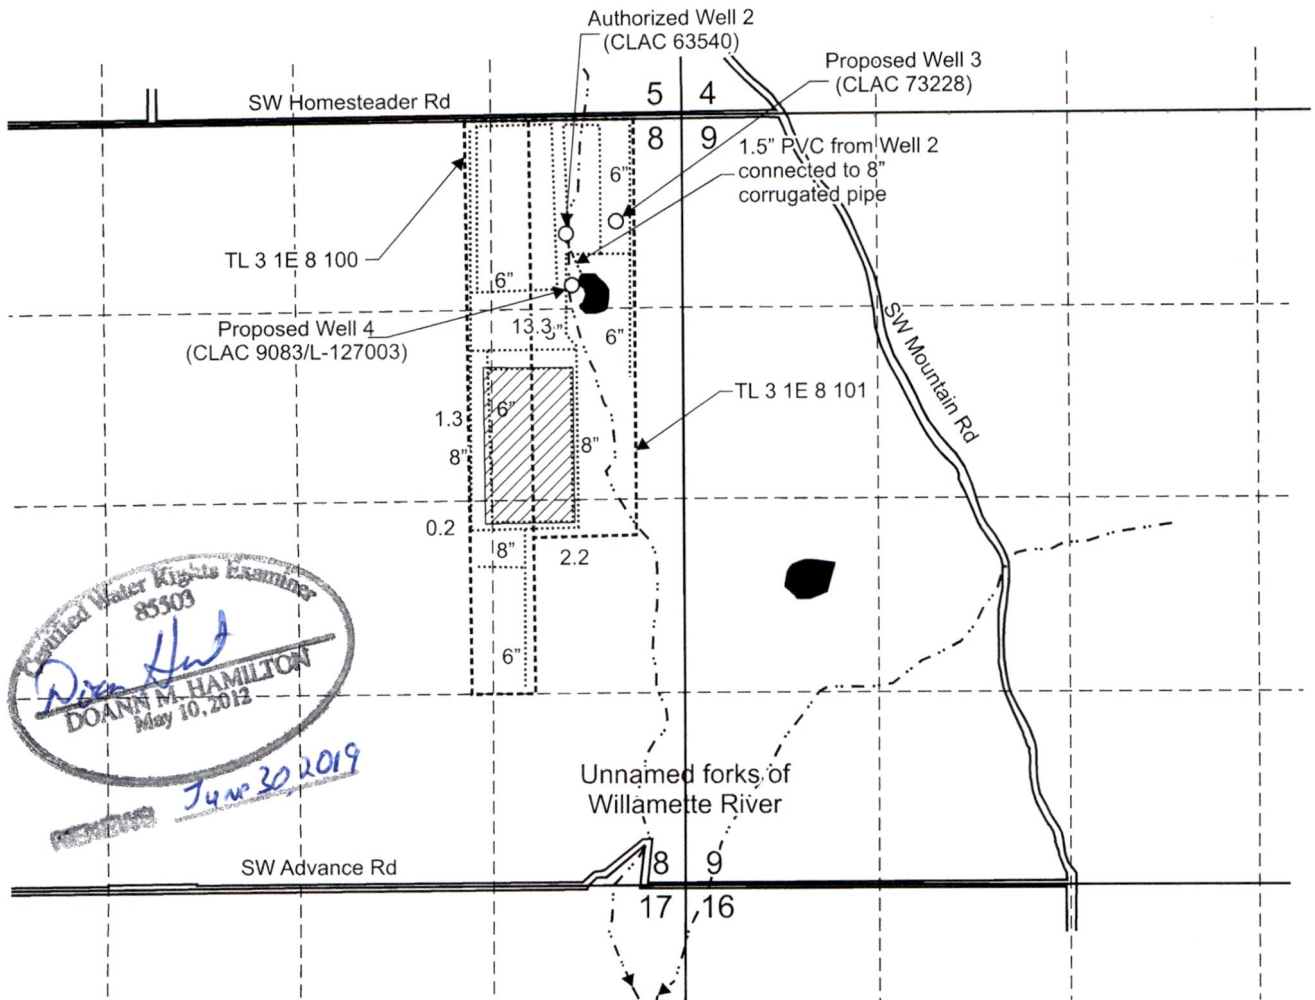


Authorized Well 2 (CLAC 63540) is located 809 feet south and 801 feet west from the NE corner, Section 8.
 Proposed Well 3 (CLAC 73228) is located 725 feet south and 455 feet west from the NE corner, Section 8.
 Proposed Well 4 (CLAC 9083/L-127003) is located 1,160 feet south and 760 feet west from the NE corner, Section 8.

 Area (17.0 Acres) irrigated under Certificate 88793, priority date August 17, 1971.

----- Tax lot boundary

..... Water main line

Scale: 1" = 1,320'

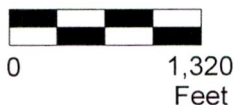

This map was prepared for the purpose of identifying the location of a water right only and is not intended to provide legal dimensions or location of property ownership lines.

RECEIVED

OCT 10 2018

OWRD



**Transfer Application Map
Certificate 88793**

Sean Tyler Keys, LLC
T.3S. R.1E. Section 8, W.M.

Pacific Hydro-Geology Inc.

09/2018