


RECEIVED

NO. 1111

11/11/11

# CLAIM OF BENEFICIAL USE MAP TO CHANGE PLACE OF USE AND ADD POINTS OF APPROPRIATION FOR APPLICATION T-13409

SECTIONS 9, 10, 15, & 16, TOWNSHIP 26 SOUTH, RANGE 30 EAST, W.M.  
TAX LOTS: 2300, 4900, 5000, 5100 & 5200

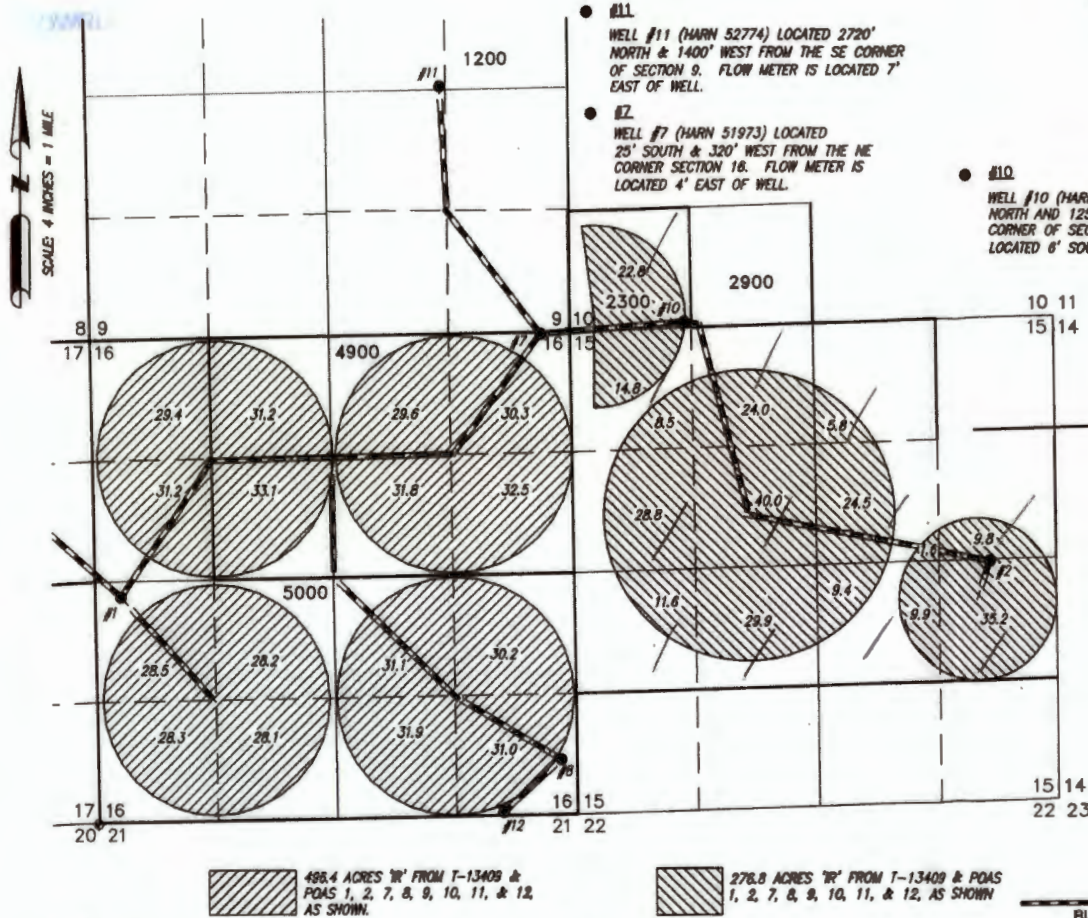

THIS MAP IS FOR THE PURPOSE OF  
LOCATING A WATER RIGHT ONLY AND HAS  
NO INTENT TO PROVIDE LEGAL DIMENSIONS  
OR THE LOCATION OF PROPERTY LINES



RENEWAL DATE: 12/31/2022

PREPARED FOR:

CHARLES AND LOUANNA EGGERT  
9955 SW POTANO STREET  
TUALATIN, OR 97062

PREPARED BY:



ALL POINTS ENGINEERING AND SURVEYING, INC.  
P.O. BOX 767 TERREBONNE, OR 97760  
(541) 548-5833 www.APEandS.com