


RECEIVED

MAY 11 2022

(T-13409)

CLAIM OF BENEFICIAL USE MAP TO CHANGE PLACE OF USE AND ADD POINTS OF APPROPRIATION FOR APPLICATION T-13409

SECTIONS 9, 10, 15, & 16, TOWNSHIP 26 SOUTH, RANGE 30 EAST, W.M.
TAX LOTS: 2300, 4900, 5000, 5100 & 5200

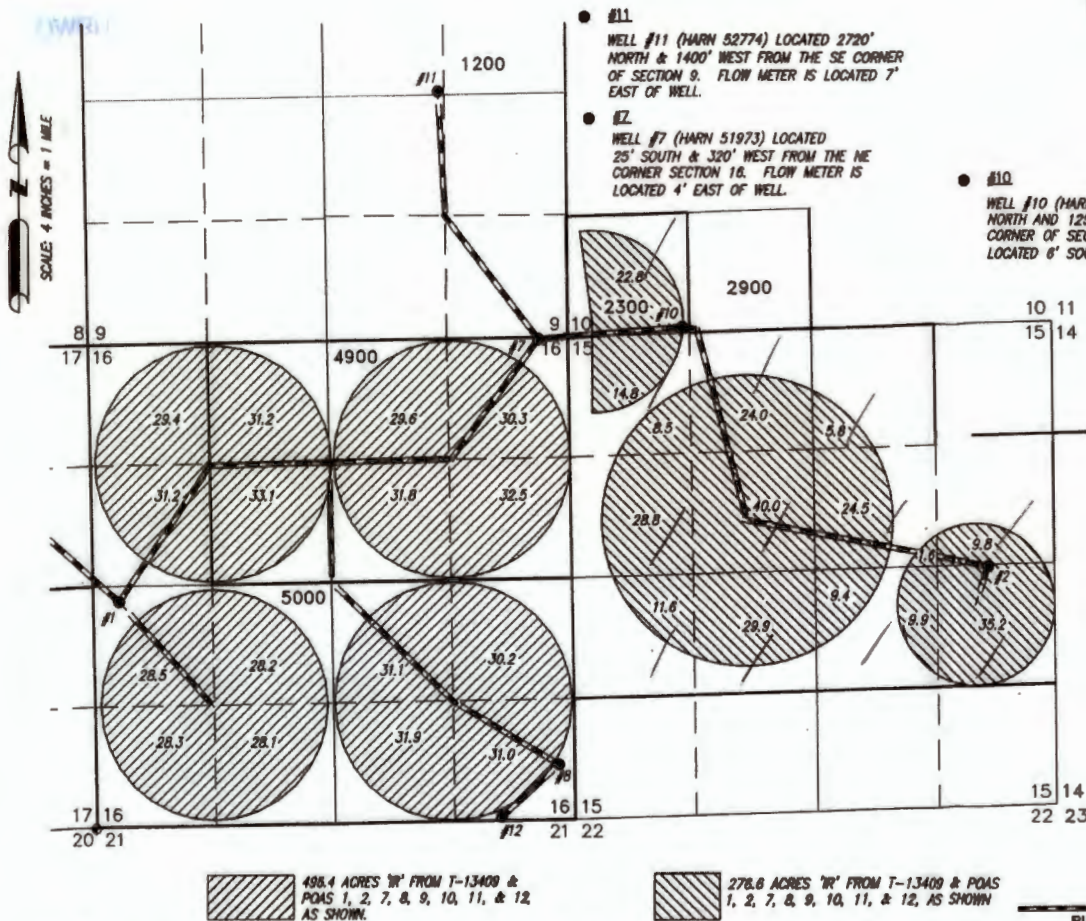

● #11

WELL #11 (HARN 52774) LOCATED 2720' NORTH & 1400' WEST FROM THE SE CORNER OF SECTION 9. FLOW METER IS LOCATED 7' EAST OF WELL.

● #7

WELL #7 (HARN 51973) LOCATED 25' SOUTH & 320' WEST FROM THE NE CORNER SECTION 16. FLOW METER IS LOCATED 4' EAST OF WELL.

● #10

WELL #10 (HARN 52639) LOCATED 65 FEET NORTH AND 1255 FEET EAST FROM THE SW CORNER OF SECTION 10. FLOW METER IS LOCATED 6' SOUTH OF WELL.

● #2

WELL #2 (MALH 2323) LOCATED 2621 FEET NORTH AND 9878 FEET EAST FROM THE SW CORNER SECTION 16. FLOW METER IS LOCATED 4' SOUTH OF WELL.

THIS MAP IS FOR THE PURPOSE OF LOCATING A WATER RIGHT ONLY AND HAS NO INTENT TO PROVIDE LEGAL DIMENSIONS OR THE LOCATION OF PROPERTY LINES



RENEWAL DATE: 12/31/2022

BURIED 6 OR 8 INCH STEEL PIPE

● #1

WELL #1 (HARN 1338) LOCATED 2484' NORTH & 285' EAST FROM THE SW CORNER SECTION 16. FLOW METER IS LOCATED 7' SOUTH OF WELL.

● #8

WELL #8 (HARN 52169) LOCATED 600' NORTH & 185' WEST FROM THE SE CORNER OF SECTION 16. FLOW METER IS LOCATED 6' EAST OF WELL.

● #12

WELL #12 (HARN 52513) LOCATED 40' NORTH & 775' WEST FROM SE 1/4 OF SECTION 16. FLOW METER IS LOCATED 6' EAST OF WELL.

PREPARED FOR:

CHARLES AND LOUANNA EGGERT
9955 SW POTANO STREET
TUALATIN, OR 97062

PREPARED BY:



ALL POINTS ENGINEERING AND SURVEYING, INC.
P.O. BOX 767 TERREBONNE, OR 97760
(541) 548-5833 www.APEandS.com