CLAIM OF BENEFICIAL USE MAP

FOR

DAVE ROTH & GAYLN ROTH

SECTIONS 1 & 2, TOWNSHIP 25 SOUTH,
RANGE 17 EAST, W.M.
SECTION 3, TOWNSHIP 25 SOUTH,
RANGE 18 EAST, W.M.
LAKE COUNTY, OREGON

Certified Water Right Examiner
005
Darryl J. Anderson
Nov.19, 1987
STATE OF OREGON

RENEWAL 12/31/23

LEGEND

- SECTION LINE
- 1/4 SECTION LINE
- 1/16 SECTION LINE
- TAXLOT LINE
- MAIN LINE PIPE

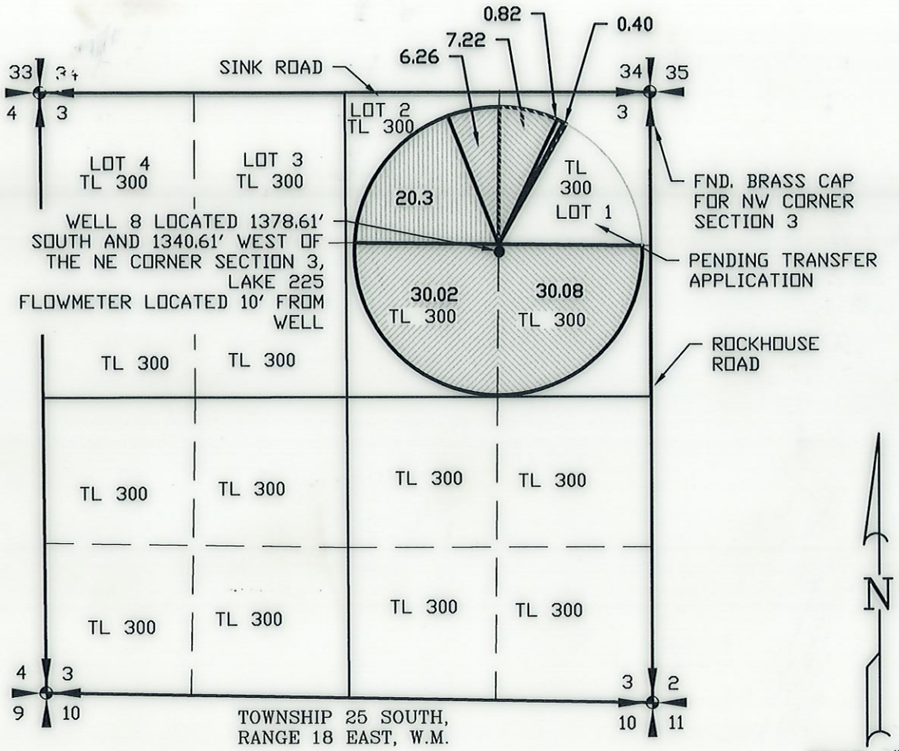

SCALE: 1"=1320'

PLACE OF USE FROM CERTIFICATE 80945
37.10 ACRES, NEW POA

PLACE OF USE FROM CERTIFICATE 67907
37.3 ACRES, NEW POA

PLACE OF USE FROM CERTIFICATE 75630
20.3 ACRES, NEW POA

PLACE OF USE FROM CERTIFICATE 43774
0.40 ACRES, NEW POA

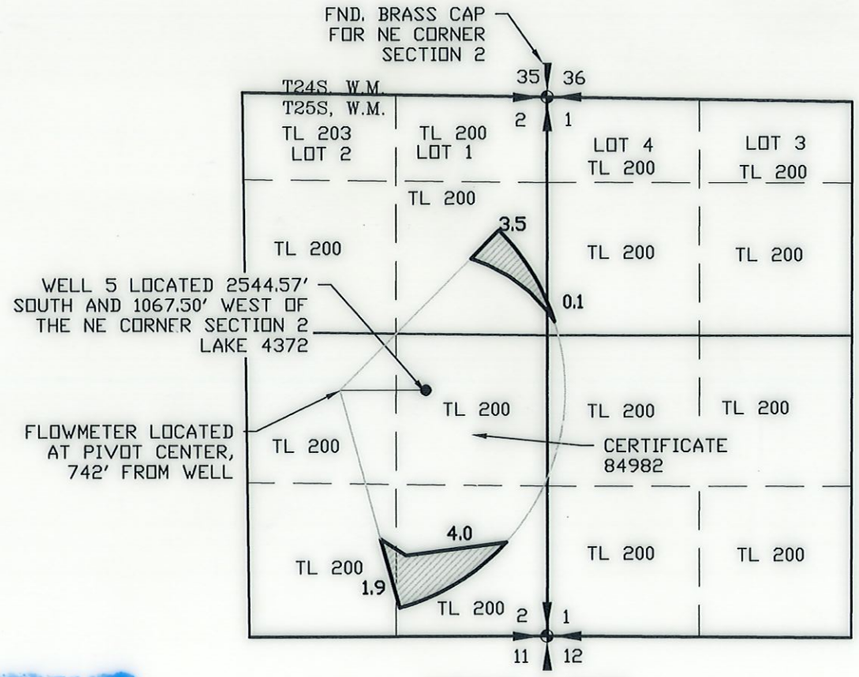

PLACE OF USE FROM CERTIFICATE 80945
9.5 ACRES – NO CHANGE IN POA

NOTE:
PREPARATION OF THIS MAP IS FOR IDENTIFYING PROPOSED WATER RIGHTS ONLY. IT HAS NO INTENT TO PROVIDE LOCATIONS OR DIMENSIONS OF PROPERTY BOUNDARIES.

RECEIVED
JUN 0 2 2022
OWRD

REVISION	BY

ANDERSON ENGINEERING AND SURVEYING, INC.
P.O. BOX 28
LAKEVIEW, OREGON 97630
(541) 947-4407/FAX: 947-2321
WWW.ANDERSONENGINEERING.COM

FOR:
DWIGHT ROTH
P.O. BOX 107
CHRISTMAS VALLEY, OR
97641

CLAIM OF BENEFICIAL MAP
TRANSFER T-9420
SEC. 3, 7 & 18, T25S, R18E W.M.

DATE:	5/11/2022
SCALE:	1" = 1320'
DWG. BY:	R.C.
JOB:	2022-066
FILE:	2022-066
SHEET:	1 OF 1