



**T30S R15W, WM,  
COOS COUNTY, OR**

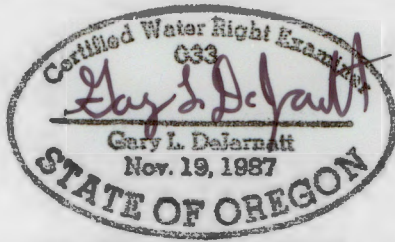

RENEWAL DATE 12/31/2023

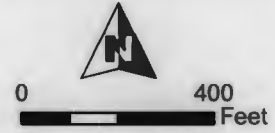

- POD/Pumps
- Shortridge Reservoir/Sump/Bulge
- Creek/Stream
- Pipeline
- Section
- Quarter Quarter
- Tax Lot
- POU S-41010 CI & TC 8/12/1976 Priority

POD Location:

2500' N, 1910' E of SW Cor Sec 13



**CLAIM OF BENEFICIAL USE MAP**

**Stoddard** Project #23005

Date: 2/16/2023

Ap S-54656 / Permit S-41010

This map is not intended to provide legal dimensions or locations of property ownership lines.

**WATER RIGHT SERVICES, LLC**

PO BOX 1830, BEND, OR 97709  
 WWW.OREGONWATER.US CCB # 197121  
 johnshort@usa.com 541-389-2837