



T.6S. R.3W. Sec. 23 & 24, W.M.

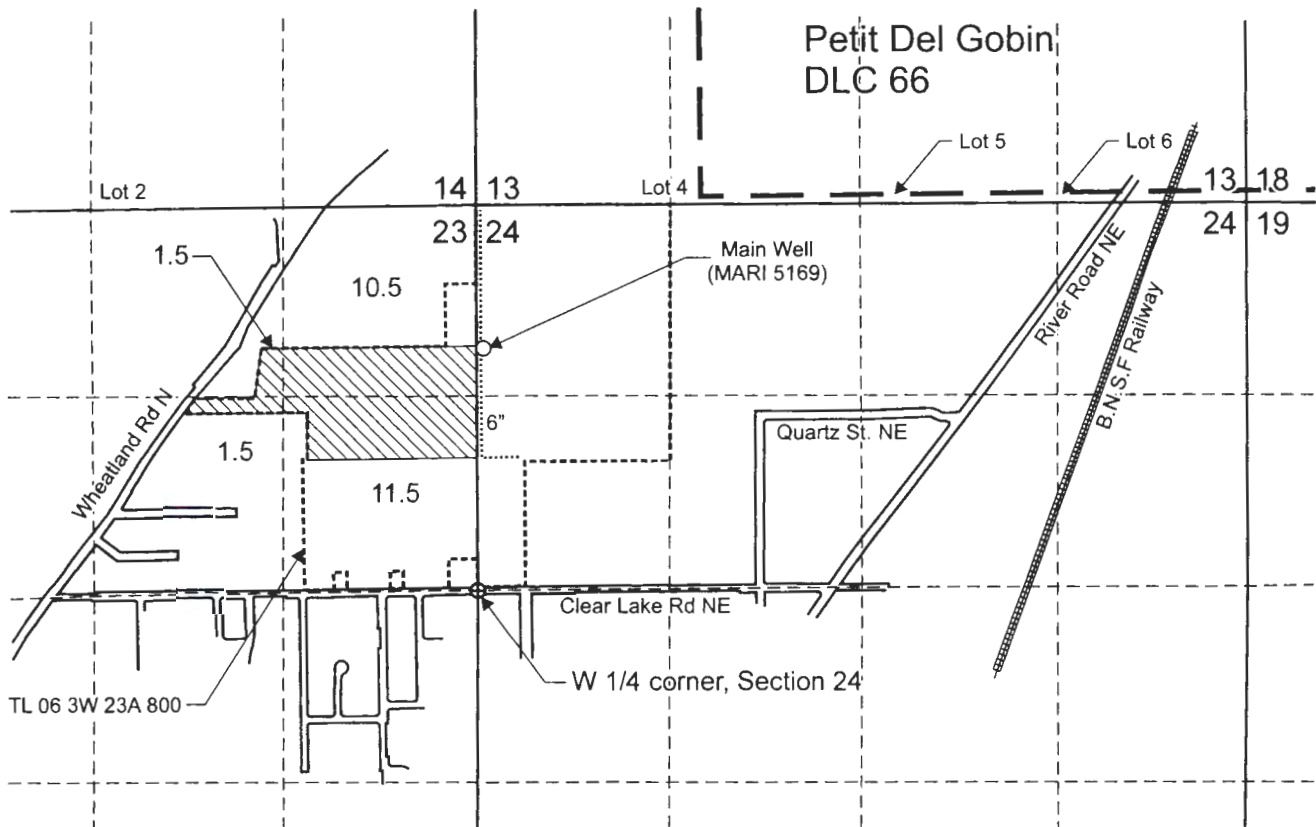

Main Well (MARI 5169) is located 1,680 feet north and 40 feet east from the W 1/4 corner, Section 24.

 Area (25.0 Acres) irrigated under T-12416.

----- Tax lot boundary

— · — Donation Land Claim boundary

..... Irrigation main line

SEP 14 2017

OWRD



RENEWED June 30 2019

Scale: 1" = 1,320'



0 1,320
Feet

This map was prepared for the purpose of identifying the location of a water right only and is not intended to provide legal dimensions or location of property ownership lines.



Claim of Beneficial Use Map
T-12416

Clearlake Farms LLC
T.6S. R.3W. Sec. 23 & 24, W.M.

Pacific Hydro-Geology Inc.

09/2017