


T.5S. R.1E. Sec. 1 and 12, W.M.

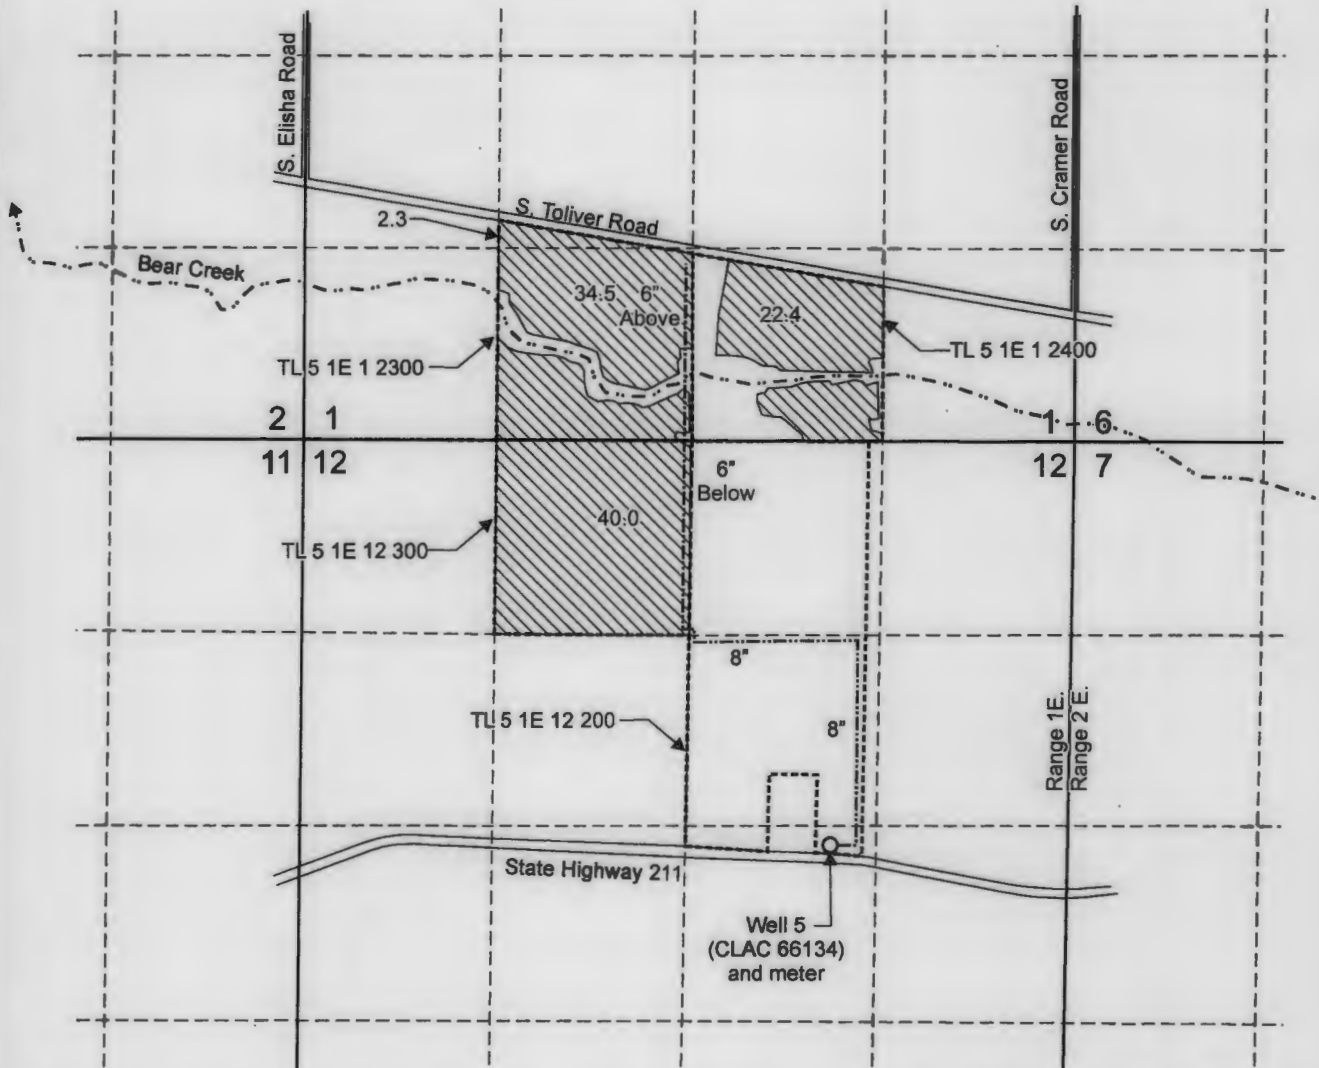

Well 5 (CLAC 66134) is located 2,750 feet south and 1,660 feet west from the NE corner of Section 12.

Area (99.2 Acres) irrigated under Application G-15661 Permit G-15254.

Tax lot boundary

Irrigation mainline

RECEIVED

JUN 19 2018

OWRD



Scale: 1" = 1,320'



This map was prepared for the purpose of identifying the location of a water right only and is not intended to provide legal dimensions or location of property ownership lines.



Pacific Hydro-Geology Inc.

06/2018

Claim of Beneficial Use Map
Application G-15661, Permit G-15254,
T-10680 & 11184

Bradley and Mary Gilbert
T.5S. R.1E. Sec. 1 and 12, W.M.