


# CLAIM OF BENEFICIAL USE

## TRANSFER T-12496

Township 26 & 27 South, Range 6 West, W.M.  
Douglas County, Oregon

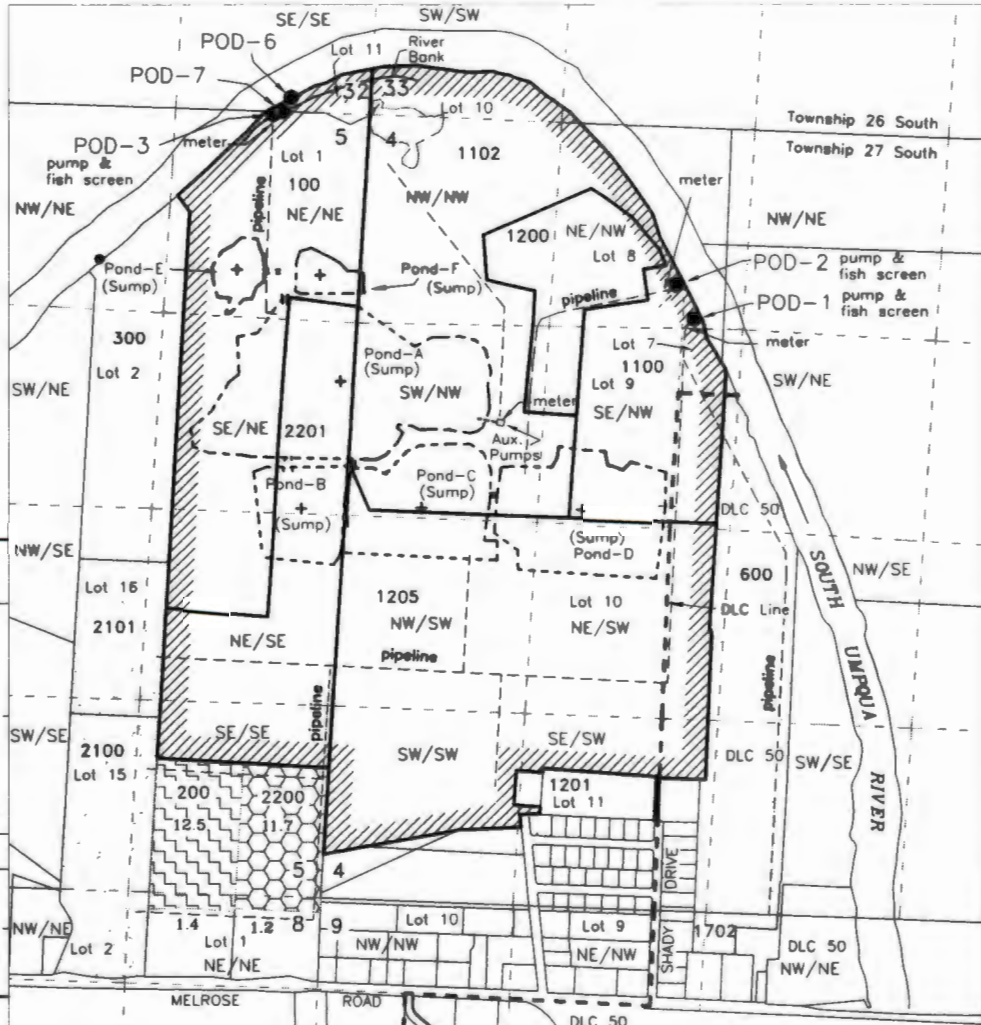

POD's for Quasi-Municipal	
POD-1,2,3	C-35454 - 1/5/1966 C-91507 - 9/26/1990 C-43742 - 3/24/1955
POD-3	
C-49118	- 5/1/1975
C-49020	- 6/1/1976
C-61946	- 7/31/1980
POD's for Irrigation	
6/1/1976	C-49020 - POD-3, 6
7/31/1980	C-61946 - POD-3, 7


**POINTS OF DIVERSION**

- POD-1 - Lot 7 (NE/NW) Section 4, 1315 ft. S & 2315 ft. E. from the NW corner Section 4 (35454, C-43742, 91507)
- POD-2 - Lot 8 (NE/NW) Section 4, 1080 ft. S & 2175 ft. E. from the NW corner Section 4 (C-43742, C-35454, 91507)
- POD-3 - NE/NE Section 5, 20 Feet South & 650 ft. W. from the NE Corner, Section 5 (C-35454, C-43742, C-49118, C-49020, C-61946, 91507)
- POD-6 - SE/SE Section 32, 100 ft. N. & 540 ft. W. from the SE corner of Section 32 (C-49020) Not changed
- POD-7 - Lot 1 (NE/NE) Section 5, 600 ft. W. from the NE corner Section 5 (C-61946) Not changed

+ Approximate center of ponds (Bulge in system)  
Auxillary pump in Pond A (ponds are connected)  
(ponds are sumps - see T-12268 & T-12269)

**PREPARED FOR:**  
GUIDO LAND & EQUIPMENT CO., LLC      CALLAHAN RIDGE, LLC  
640 SHADY DRIVE                                      &      640 SHADY DRIVE  
ROSEBURG, OR 97471                                      ROSEBURG, OR 97471

	Quasi-Municipal Use - per transfer POD 1, 2 & 3 (see table above)
	Additional property acquired for Quasi-Municipal Use after transfer application submitted
	Irrigation- POD-3, 6 (C-49020) } Guido Rentals, LLC 3077 Garden Valley Road Roseburg, OR 97471
	Irrigation- POD-3, 7 (C-61946)

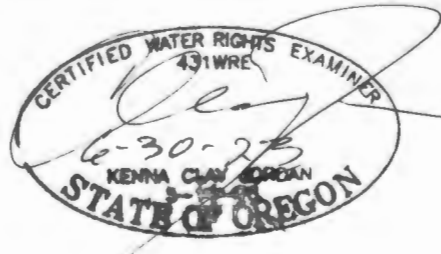

For purpose of locating POD's, Cardinal directions are in reference from point of beginning extending along section or DLC boundary lines

**Scale**  
1" = 1320'

This map is not intended to provide legal dimensions or locations of property ownership lines

Base Map: Douglas County GIS data with September 2022 Oregon Map aerial photo overlay for assumed best fit

**JORDAN ENGINEERING**  
460 JORDAN LANE  
ROSEBURG, OR 97471  
(541) 673-1931  
Drawn: 10/3/2022 n.e.d.  
Rev: 12/20/2022 n.e.d.