
Township 4 North, Range 28 East - Section 23 UMATILLA COUNTY

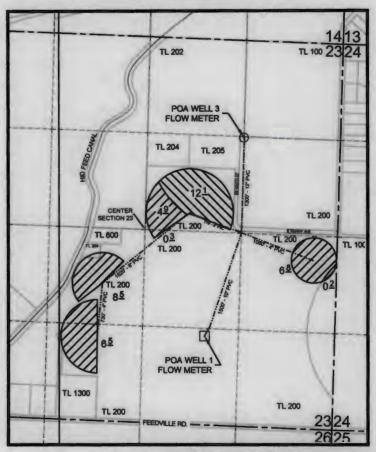



LEGEND

SECTION LINES
Q-Q SECTION LINES

PIPELINES

TAX LOTS

TL 200 TAX LOT NUMBER

27.2 AC FROM CERT 79889 TO NEW POU WITH POAs

> 12.1 AC FROM CERT 79889 WITH ADDITIONAL POA

POINTS OF APPROPRIATION

EXISTING POA WELL 3 O 1350'S 1330'W FROM NE COR,

SEC 23, T4N, R28E, W.M.


NEW POA WELL 1 ☐ 1210'N 1800'W FROM SE COR, SEC 23, T4N, R28E, W.M.

COBU MapTransfer T-11254

In the name of the Stanfield Hutterian Farm November 16th, 2022

THIS MAP WAS PREPARED FOR THE PURPOSE OF IDENTIFYING THE LOCATION OF A WATER RIGHT ONLY AND IS NOT INTENDED TO PROVIDE LEGAL DIMENSIONS OR LOCATION OF PROPERTY OWNERSHIP LINES.

JUL 2 8 2023 OWRD

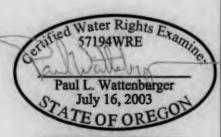

EXPIRES: 6/30/24