

FINAL PROOF MAP

TO TRANSFER RIGHTS AND
ADD A POINT OF APPROPRIATION
FOR T-10501
KENETH AND TINA GRASSMAN

RECEIVED


AUG 17 2010

WATER RESOURCES DEPT
SALEM, OREGON

TOWNSHIP 27 SOUTH, RANGE 18 EAST, SECTION 5, W.M.
TAX LOT: 600 LAKE COUNTY, OREGON



26.5 ACRES FROM G-6583
(CERT. # 47725) TO BE
TRANSFERRED, AS SHOWN

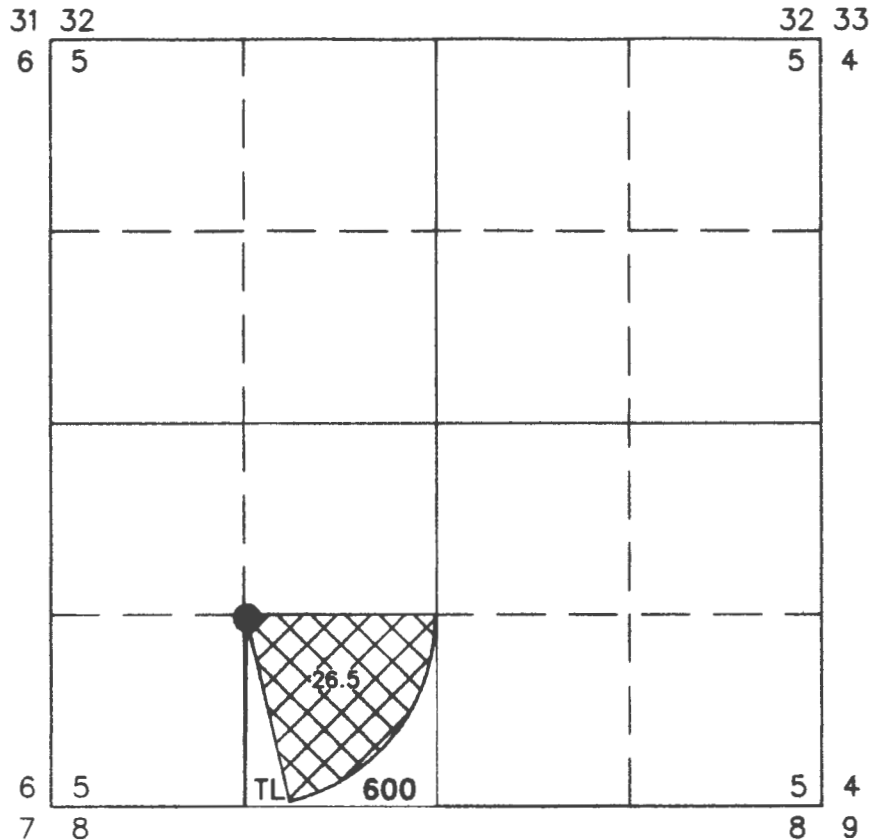

RENEWAL DATE: 12/31/2010

● A WELL

EXISTING WELL (LAKE 4318) PERMIT: G-6583
1300' NORTH 1340' EAST FROM THE SW CORNER SECTION 5

METER IS LOCATED ON THE DELIVERY PIPE 8 FEET NORTH OF
THE WELL

THIS MAP IS FOR THE PURPOSE OF LOCATING A WATER RIGHT ONLY AND HAS NO
INTENT TO PROVIDE LEGAL DIMENSIONS OR THE LOCATION OF PROPERTY LINES

PREPARED FOR:

KENETH AND TINA GRASSMAN
P.O. BOX 393
CHRISTMAS VALLEY, OR 97641

PREPARED BY:



ALL POINTS ENGINEERING AND SURVEYING, INC.
P.O. BOX 767 (CRR) TERREBONNE, OR 97760
(541) 548-5833
www.APEandS.com